IREDELL COUNTY HEALTH DEPARTMENT

STATESVILLE 704-878-5305 MOORESVILLE 704-664-5281

IMPROVEMENT PERMIT / AUTHORIZATION TO CONSTRUCT / OPERATION PERMIT / EXISTING SYSTEM INSPECTION

PERMIT# 81090 PIN# 4726 70 4812 DATE June 3, 99

OWNER OR CONTRACTOR David Perry PHONE: Business 539-5169 Home

ADDRESS 382 York-Sparta Rd. Hamptonville, NC 27020

LOCATION 115 W (L) Scotts Creek (L) Millers Farm on Right

SUBDIVISION Fawnwood BLOCK / SECTION 1 LOT 8 LOT AREA .64Ac SITE CLASS 5 DESIGN FLOW 360 L.T.A.R. .3

Septic Tank: 1000 Gallons; STB 1012 Date 10 9 99
Pump Tank: 1000 Gallons; PT 17 Date
Pump Make: SQUIRT Model WE0311M Serial No. H9861043
Nitrification Field: No Fields 1 Square Feet 1200 Linear Feet 450
No Lines 5 Trench Width 36" Max Trench Bottom Depth 36" Gravel Depth 12"

☒ New System ☐ Repair System Type: I, II, ☒ IV, V, VI
System Description: Conventional / Pump
Repair System Description: Same
Maintenance Agreement Required: ☐ Yes ☒ No

☒ House/Mod. Home No. Bedrooms 3
☐ Mobile Home No. Bathrooms 2
☐ Business No. Employees
☐ Other


☐ Slab ☒ Crawl Space ☐ Basement w/plumbing ☐ Basement wo/plumbing

Water Supply: ☐ Individual ☒ Public ☐ Community

Comments/Conditions: INSTALL lines on CONTOUR

Comments/Conditions: JAN 14-2000 Line & TANK installed As shown SEPTIC TANK W/ MARKER INSTALLED USING "POLYLOK" FILTER

INITIAL SITE SKETCH

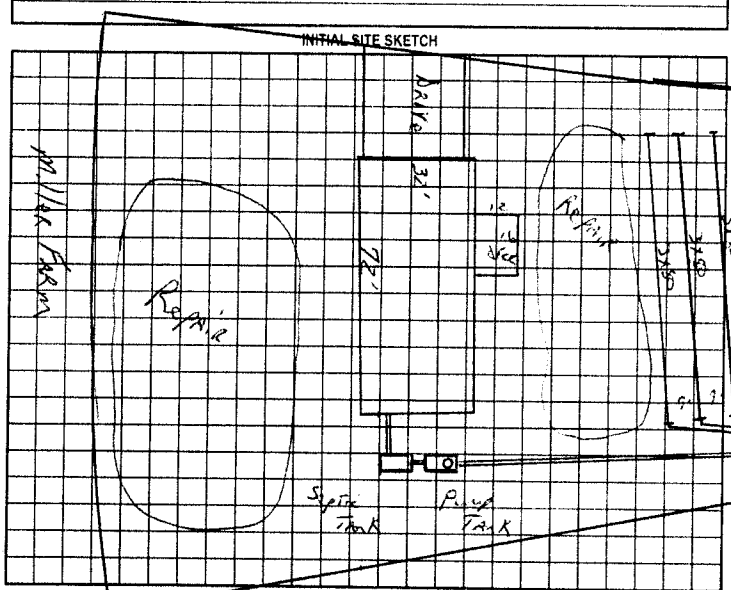

AS BUILT SKETCH

PRESSURE CHECK 2-16-00 - OK

SYSTEM INSTALLED ACCORDING TO INITIAL SITE SKETCH

Permit can be suspended or revoked if any false information is supplied toward securing the permit/any unauthorized changes are made to the site/any unauthorized changes are made in the installation of the system. Improvement Permit with plat valid without expiration. Improvement Permit with site plan valid for sixty months. Authorization to Construct is valid for a period equal to that of Improvement Permit – not to exceed sixty months.

Signed: David McPerry date 6-7-99
Improvement Permit by: L. Potter date 6.7.99
Authorization to Construct by: L. Potter date 6.7.99

Installed by: T. Frye
Operation Permit by: STEVE HARRICK date 2-23-00
Existing System Inspection by: date

HEALTH DEPT. COPY: WHITE OWNER COPY (FINAL) YELLOW OWNER COPY (INITIAL) PINK