IREDELL COUNTY HEALTH DEPARTMENT

STATESVILLE 704-878-5305 MOORESVILLE 704-664-5281

IMPROVEMENT PERMIT / AUTHORIZATION TO CONSTRUCT / OPERATION PERMIT / EXISTING SYSTEM INSPECTION

PERMIT# 079053 PIN# 4736709215 (PART) DATE 1-30-99

OWNER OR CONTRACTOR STANDARD BUILDING PHONE: Business Home 585-2211

ADDRESS 202 HARRIS BRIDGE ROAD, STONY POINT, NC 28678

LOCATION NC 115 N, TL SCOTTS CREEK RD, TL MILLER FARM RD, ON RIGHT ACROSS FROM SWEETWATER LANE

SUBDIVISION FAWNWOOD BLOCK / SECTION F LOT 9 LOT AREA 0.596 ACRE SITE CLASS. PS DESIGN FLOW 360 L.T.A.R. 0.30 GPD/FT2

Septic Tank: 1000 Gallons; STB 1013 Date 3-24-99
Pump Tank: 1000 Gallons; PT 17 Date 3-8-99
Pump Make: Goulds Model WE03111M Serial No. 9979528
Nitrification Field: No Fields 1 Square Feet 1200 Linear Feet 400
No Lines SIX Trench Width 36" Max Trench Bottom Depth 36" Gravel Depth 12"

☐ New System ☐ Repair System Type: I, II, III, IV, V, VI
System Description: CONVENTIONAL, PUMP-FED
Repair System Description: 25% REDUCTION PUMP-FED
Maintenance Agreement Required: ☐ Yes ☑ No
☐ Slab ☑ Crawl Space ☐ Basement w/plumbing ☐ Basement wo/plumbing


☑ House/Mod. Home No. Bedrooms 3
☐ Mobile Home No. Bathrooms 2
☐ Business No. Employees
☐ Other

Water Supply: ☐ Individual ☑ Public ☐ Community


Comments/Conditions: SEE ATTACHED SHEETS FOR PUMP AND PRESSURE MANIFOLD REQUIREMENTS

Comments/Conditions:
5-17 Checked Drain lines, Tank, set pressure head.
6-7 ELECTRICAL BOX CHECKED OK, RSH

INITIAL SITE SKETCH

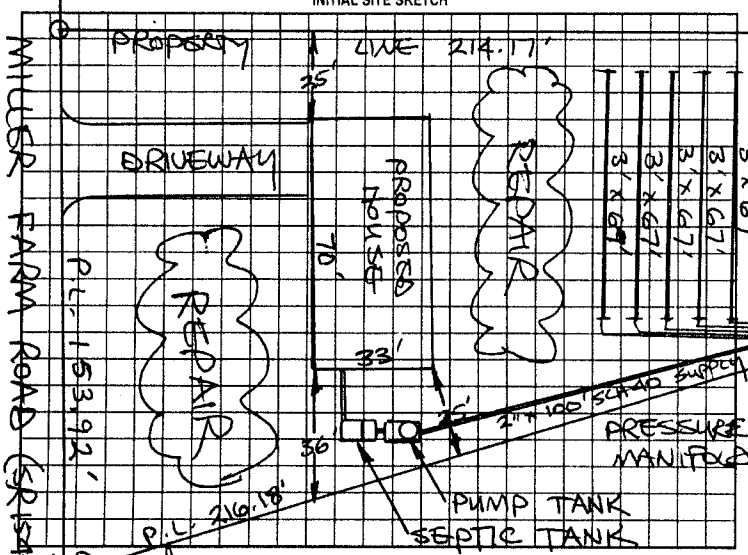

AS BUILT SKETCH

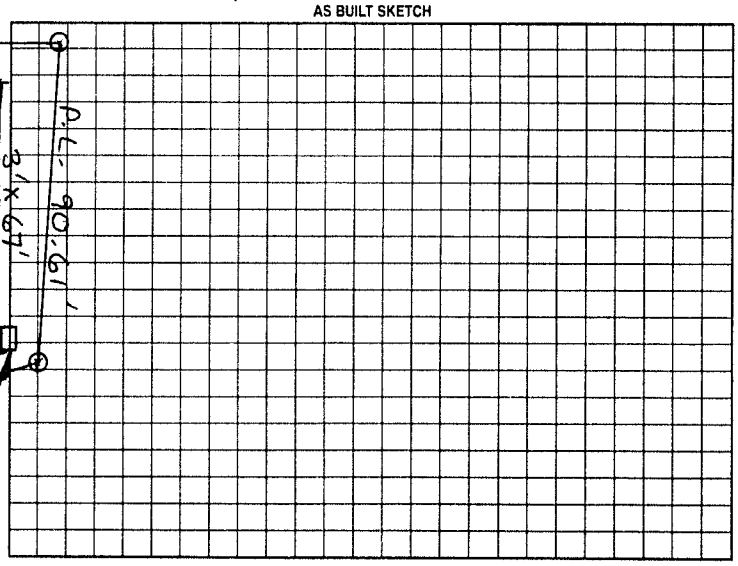

Permit can be suspended or revoked if any false information is supplied toward securing the permit/any unauthorized changes are made to the site/any unauthorized changes are made in the installation of the system. Improvement Permit with plat valid without expiration. Improvement Permit with site plan valid for sixty months. Authorization to Construct is valid for a period equal to that of Improvement Permit – not to exceed sixty months.

Signed: _____ date 1-30-99 Installed by: Tommy Frye

Improvement Permit by: STEVE HEDRICK date 1-30-99 Operation Permit by: [illegible] date 6-15-99

Authorization to Construct by: STEVE HEDRICK date 1-30-99 Existing System Inspection by: _____ date _____

HEALTH DEPT. COPY: WHITE OWNER COPY (FINAL): YELLOW OWNER COPY (INITIAL): PINK