46910

IREDELL COUNTY HEALTH DEPARTMENT

STATESVILLE 704-878-5305 MOORESVILLE 704-664-5281

IMPROVEMENT PERMIT / CERTIFICATE OF COMPLETION / OPERATION PERMIT / EXISTING SYSTEM INSPECTION

PROPERTY DESCRIPTION NO. 16166 DATE 6-3-93 TAX MAP NO. 9A-9-A-26

OWNER OR CONTRACTOR W & W Sales, Inc. PHONE: Business Home

ADDRESS

LOCATION Hwy 115N TL Scotts Creek Rd. TL Miller Farm Rd. TR Doe Trail, 6th lot on L

SUBDIVISION Deercroft BLOCK / SECTION LOT 26 LOT AREA Ample 119'x192' SITE CLASS P.S. L.T.A.R. .35 gpd/ft²

Water Supply: ☐ Individual ☐ Community ☑ Public

Septic Tank: 1000 Gallons: STB 1012 Date 3-23-93

Pump Tank: — Gallons: PT — Date —

Nitrification Field: No Fields 1 Square Feet 1035 Linear Feet 345'

☑ No Lines 4 Trench Width 36" Trench Depth 36" Gravel Depth 12"

☑ New System ☐ Repair System Type: (I) II. IV. V. VI

System Description: Conventional, gravity

Repair System Description: "

Maintenance Agreement Required: ☐ Yes ☑ No

☑ House/Mod. Home ☐ Mobile Home ☐ Business ☐ Other

No. Bedrooms 3 No. Bathrooms 2 No. Employees —

☐ Slab ☑ Crawl Space ☐ Basement w/plumbing ☐ Basement wo/plumbing

Garbage Disposal: ☐ Yes ☑ No


Auto. Dishwasher: ☑ Yes ☐ No

Auto. Washing Machine: ☑ Yes ☐ No


Other

Comments 100% Repair Area below system, conventional, gravity fed.

INITIAL SITE SKETCH

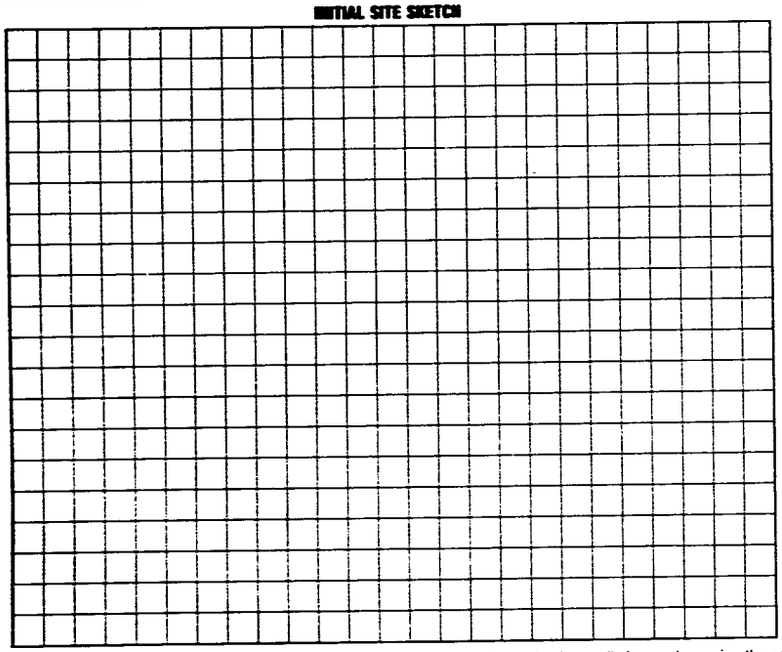

AS BUILT SKETCH

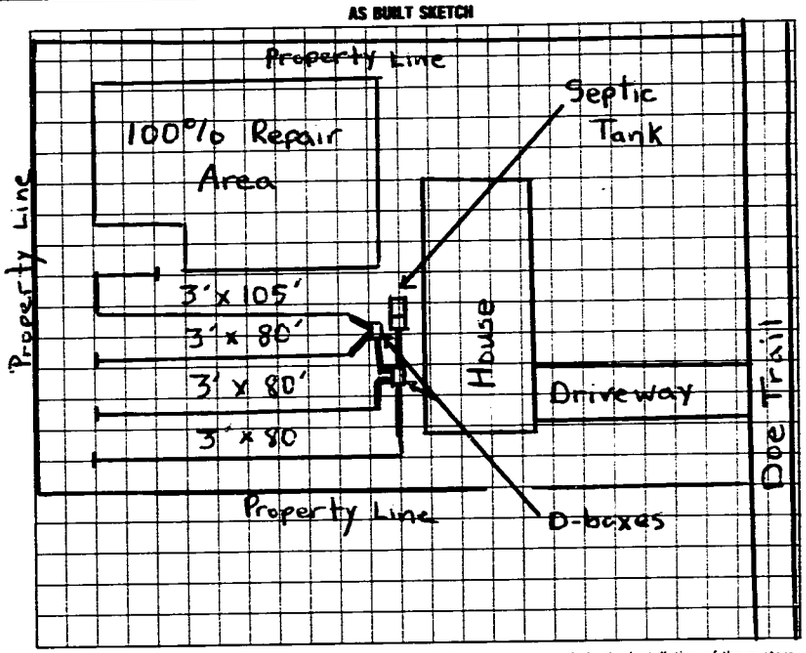

I understand that this permit can be suspended or revoked if any false information is supplied toward securing the permit/any unauthorized changes are made to the site/any unauthorized changes are made in the installation of the system. Improvement Permit is valid for 60 months from date of issuance.

Signed:

Improvement Permit by: Steve Hedrick date 4-14-93

Existing System Inspection by: date

Installed by: Tommy Fry

Certificate of Completion by: Michael J. Dennis date 6-3-93

Operation Permit by: date

HEALTH DEPT. COPY: WHITE INSPECTION COPY (FINAL): GREEN OWNER COPY (FINAL): YELLOW INSPECTION COPY (INITIAL): PINK OWNER COPY (INITIAL): GOLD