IREDELL COUNTY HEALTH DEPARTMENT

STATESVILLE 704-878-5305 MOORESVILLE 704-664-5281

55021

IMPROVEMENT PERMIT / CERTIFICATE OF COMPLETION / OPERATION PERMIT / EXISTING SYSTEM INSPECTION

PROPERTY DESCRIPTION NO. 20583 DATE 3/20/95 TAX MAP NO. 9A-9-A-28 Watershed: ☐ Yes ☒ No

OWNER OR CONTRACTOR RICK DYSON PHONE: Business Home 528-6649

ADDRESS 120 HICKORY POINT COURT STATESVILLE NC 28677

LOCATION NC 115 N, TL SCOTTS CREEK, TL MILLER FARM, TR DOE TRAIL 4TH LOT ON LEFT

SUBDIVISION DEERCROFT BLOCK / SECTION I LOT 28 LOT AREA 119 x 203 x 119 x 188 SITE CLASS. PS DESIGN FLOW 360 L.T.A.R. 0.35 GPD/FT2

Septic Tank: 1000 Gallons; STB 794 Date 3/22/95

Pump Tank: ____ Gallons; PT ____ Date ____

Pump Make: ____ Model ____ Serial No. ____

Nitrification Field: No Fields 1 Square Feet 1035 Linear Feet 345

No Lines 5 Trench Width 36" Max Trench Bottom Depth 18-36" Gravel Depth 12"

☒ New System ☐ Repair System Type: ☒ III, IV, V, VI

System Description: CONV. GRAVITY

Repair System Description: CONV. GRAVITY

Maintenance Agreement Required: ☐ Yes ☒ No

☒ House/Mod. Home No. Bedrooms 3

☐ Mobile Home No. Bathrooms 2

☐ Business No. Employees ____

☐ Other ____


☐ Slab ☒ Crawl Space ☐ Basement w/plumbing ☐ Basement wo/plumbing

Water Supply: ☐ Individual ☐ Community ☒ Public

Comments:

Comments:

INITIAL SITE SKETCH

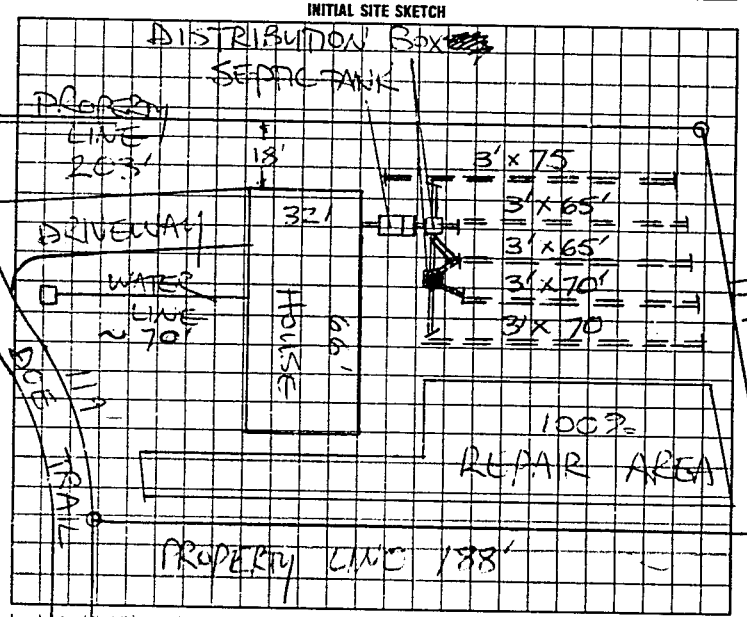

AS BUILT SKETCH

SYSTEM INSTALLED ACCORDING TO INITIAL SITE SKETCH

I understand that this permit can be suspended or revoked if any false information is supplied toward securing the permit/any unauthorized changes are made to the site/any unauthorized changes are made in the installation of the system. Improvement Permit is valid for 60 months from date of issuance.

Signed: [signature]

Improvement Permit by: STEVE HERRICK date 3/20/95

Existing System Inspection by ____ date ____

Installed by: WEBB LYNTON

Certificate of Completion by: STEVE HERRICK date 5/31/95

Operation Permit by ____ date ____

HEALTH DEPT COPY: WHITE INSPECTION COPY (FINAL): GREEN OWNER COPY (FINAL): YELLOW INSPECTION COPY (INITIAL): PINK OWNER COPY (INITIAL): GOLD

ES1000