3:30 Yountz

56354

IREDELL COUNTY HEALTH DEPARTMENT

STATESVILLE 704-878-5305 MOORESVILLE 704-664-5281

IMPROVEMENT PERMIT / CERTIFICATE OF COMPLETION / OPERATION PERMIT / EXISTING SYSTEM INSPECTION

PROPERTY DESCRIPTION NO. 21387 DATE 6-19-95 TAX MAP NO. 9A-9-A-4 Watershed: ☐ Yes ☑ No

OWNER OR CONTRACTOR G & G BUILDING PHONE: Business _____ Home _____

ADDRESS 184 SERENITY DRIVE MOCKSVILLE, NC 27028

LOCATION NC 115 N, TL SCOTTS CREEK, TL MILLER FARM, TR DOE TRAIL, 4th LOT ON RIGHT

SUBDIVISION DEERCROFT BLOCK / SECTION I LOT 4 LOT AREA ~108x250' SITE CLASS. PS DESIGN FLOW 360' L.T.A.R. 0.35 GPA/D

Septic Tank: 1000 Gallons; STB 1612 Date 8-8-95
Pump Tank: _____ Gallons; PT _____ Date _____
Pump Make: _____ Model _____ Serial No. _____
Nitrification Field: No Fields 1 Square Feet 1035 Linear Feet 345
No Lines 4 Trench Width 36" Max Trench Bottom Depth 18-36" Gravel Depth 12"

☑ New System ☐ Repair System Type: I, II, III, IV, V, VI
System Description: CONVENTIONAL GRAVITY
Repair System Description: CONV. GRAVITY
Maintenance Agreement Required: ☐ Yes ☑ No


☑ House/Mod. Home No. Bedrooms 3
☐ Mobile Home No. Bathrooms 2
☐ Business No. Employees ____
☐ Other _____
☐ Slab ☑ Crawl Space ☐ Basement w/plumbing ☐ Basement wo/plumbing

Water Supply:
☐ Individual
☐ Community
☑ Public


Comments:

Comments:

INITIAL SITE SKETCH

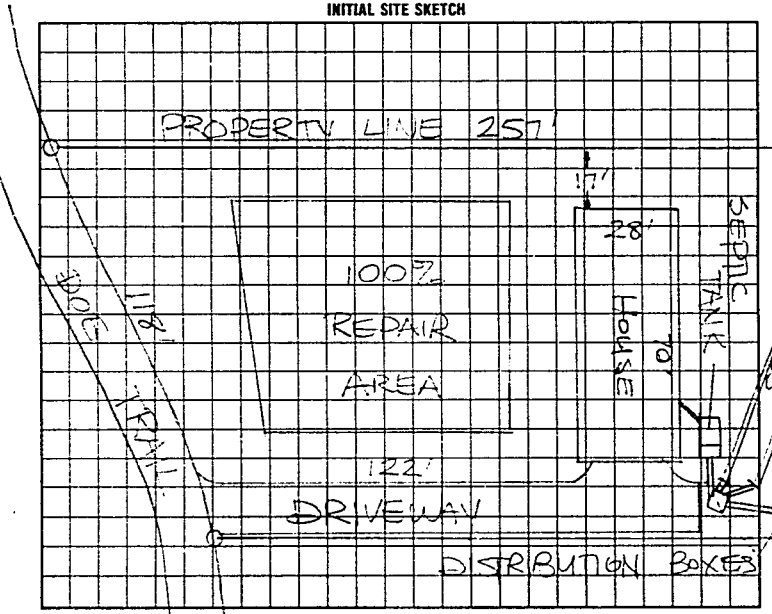

AS BUILT SKETCH

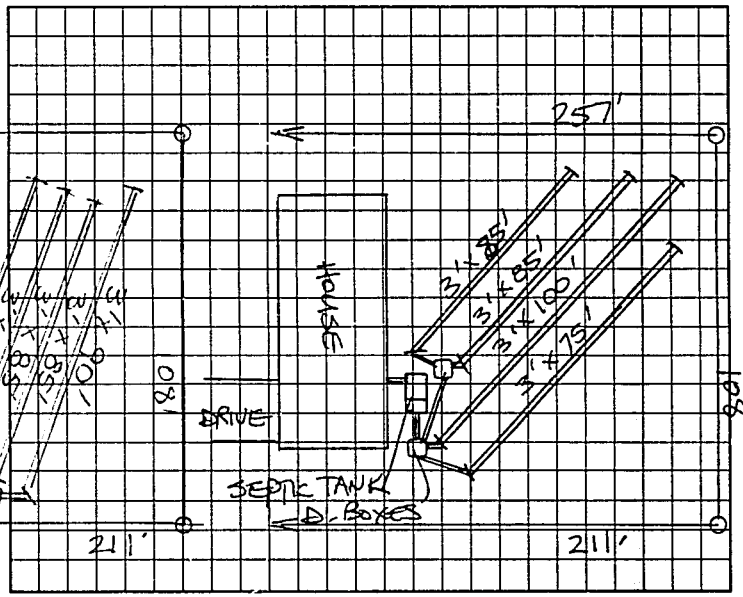

I understand that this permit can be suspended or revoked if any false information is supplied toward securing the permit/any unauthorized changes are made to the site/any unauthorized changes are made in the installation of the system. Improvement Permit is valid for 60 months from date of issuance.

Signed: Michael L. Matthews

Improvement Permit by: STEVE HEDRICK date 6-19-95

Existing System Inspection by: _____ date _____

Installed by: DAVID YOUNTZ

~~Certificate of Completion by:~~ _____ date _____

Operation Permit by: STEVE HEDRICK date 10-12-95

HEALTH DEPT. COPY: WHITE INSPECTION COPY (FINAL): GREEN OWNER COPY (FINAL): YELLOW INSPECTION COPY (INITIAL): PINK OWNER COPY (INITIAL): GOLD