IREDELL COUNTY HEALTH DEPARTMENT

STATESVILLE 704-878-5305 MOORESVILLE 704-664-5281

IMPROVEMENT PERMIT / CERTIFICATE OF COMPLETION / OPERATION PERMIT / EXISTING SYSTEM INSPECTION

PROPERTY DESCRIPTION NO. 16149 DATE 7/2/93 TAX MAP NO. 9A-9-A-57

OWNER OR CONTRACTOR Jeffrey Todd Ellis PHONE: Business Home

ADDRESS

LOCATION NC 115 N TL SCOTIA CREEK RD, TL MILLER FARM RD, TR ANTLER DR, 3RD LOT ON (L)

SUBDIVISION Deercroft BLOCK / SECTION LOT 57 LOT AREA 110x290' SITE CLASS PS L.T.A.R. 0.356 GPD/FT²

Water Supply: ~~Individual~~ ☐ Community ☑ Public > 3000 PSI

Septic Tank: 1000 Gallons: STB Date 6/10/93

Pump Tank: Gallons: PT Date 358

Nitrification Field: No Fields Square Feet 1035 Linear Feet 345

No Lines 3 Trench Width 36" Trench Depth ≤ 36" Gravel Depth 12"

☑ New System ☐ Repair System Type: I. II. III. IV. V. VI

System Description: CONV. GRAVITY

Repair System Description: CONV. GRAVITY

Maintenance Agreement Required: ☐ Yes ☑ No

☑ House/Mod. Home ☐ Mobile Home ☐ Business ☐ Other

No. Bedrooms 3 No. Bathrooms 2 No. Employees

☐ Slab ☑ Crawl Space ☐ Basement w/plumbing ☐ Basement wo/plumbing

Garbage Disposal: ☐ Yes ☑ No

Auto. Dishwasher: ☐ Yes ☐ No


Auto. Washing Machine: ☑ Yes ☐ No

Other

Comments

INITIAL SITE SKETCH

AS BUILT SKETCH

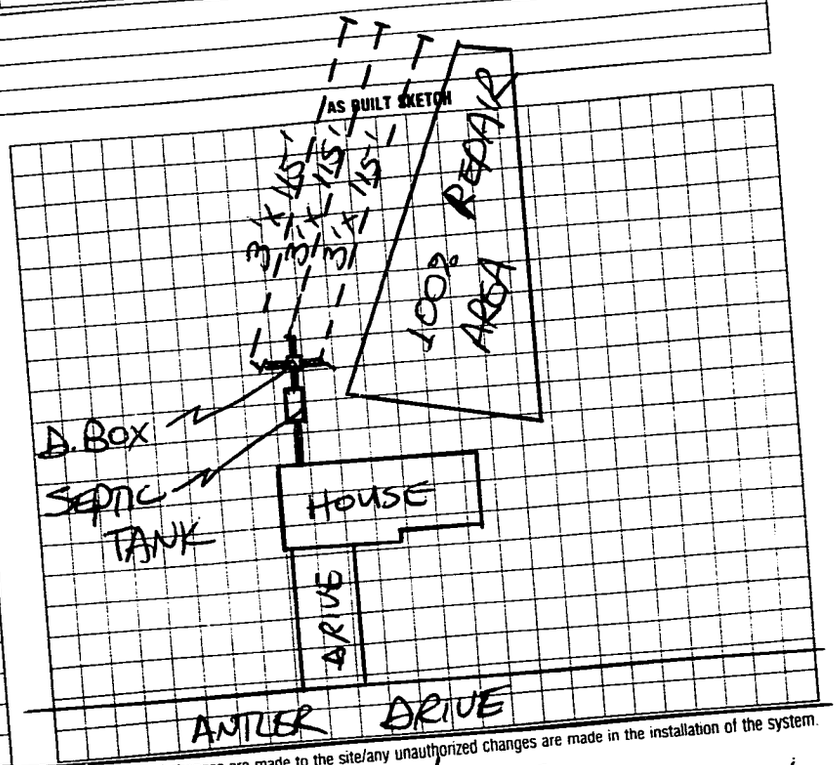

I understand that this permit can be suspended or revoked if any false information is supplied toward securing the permit/any unauthorized changes are made to the site/any unauthorized changes are made in the installation of the system. Improvement Permit is valid for 60 months from date of issuance.

Signed: date 4/13/93 Installed by: DAVID YOUNTS date 7/2/93

Improvement Permit by: STEVE HEDRICK date Certificate of Completion by: STEVE HEDRICK date

Existing System Inspection by: date Operation Permit by:

HEALTH DEPT. COPY: WHITE INSPECTION COPY (FINAL): GREEN OWNER COPY (FINAL): YELLOW INSPECTION COPY (INITIAL): PINK OWNER COPY (INITIAL): GOLD