Bruce Porter

57803

IREDELL COUNTY HEALTH DEPARTMENT

STATESVILLE 704-878-5305 MOORESVILLE 704-664-5281

IMPROVEMENT PERMIT / CERTIFICATE OF COMPLETION / OPERATION PERMIT / EXISTING SYSTEM INSPECTION

PROPERTY DESCRIPTION NO. 21693 DATE 7-21-95 TAX MAP NO. 9A-9-A-29 Watershed: ☐ Yes ☒ No

OWNER OR CONTRACTOR GIBSON BLD. PHONE: Business 878-9314 Home 878-6427

ADDRESS P.O. BOX 1726 STVL NC 28687

LOCATION NC 115 N, TL SCOTTS CREEK, TL MILLER FARM, TR DOE TRAIL, 3RD LOT ON LEFT

SUBDIVISION DEERCROFT BLOCK / SECTION I LOT 29 LOT AREA ~110'x200' SITE CLASS. PSI DESIGN FLOW 360 L.T.A.R. 0.35 GPD/FT2

Septic Tank: 1000 Gallons; STB 1012 Date 11/4/95

Pump Tank: _____ Gallons; PT _____ Date _____

Pump Make: _____ Model _____ Serial No. _____

Nitrification Field: No Fields 1 Square Feet 1035 Linear Feet 345

No Lines 4 Trench Width 36" Max Trench Bottom Depth 18-36" Gravel Depth 12"

☒ New System ☐ Repair System Type: I II III IV V VI

System Description: CONVENTIONAL GRAVITY

Repair System Description: CONV. GRAVITY

Maintenance Agreement Required: ☐ Yes ☒ No

☐ Slab ☒ Crawl Space ☐ Basement w/plumbing ☐ Basement wo/plumbing

☒ House/Mod. Home No. Bedrooms 3/2

☐ Mobile Home No. Bathrooms

☐ Business No. Employees


☐ Other

Water Supply: ☐ Individual ☐ Community ☒ Public


Comments:

Comments:

INITIAL SITE SKETCH

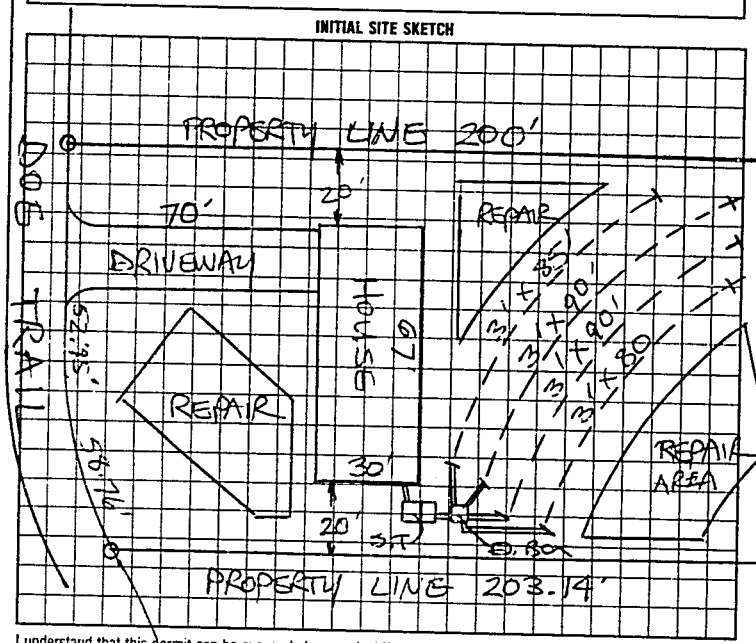

AS BUILT SKETCH

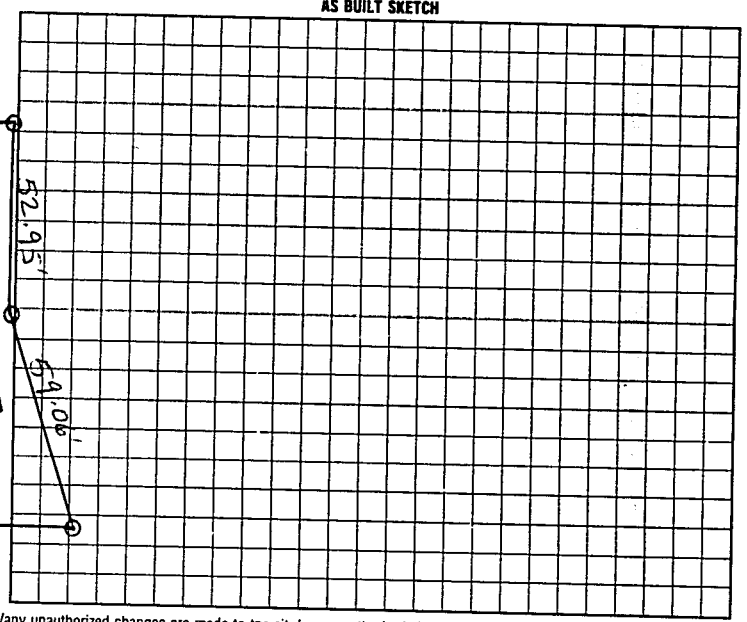

I understand that this permit can be suspended or revoked if any false information is supplied toward securing the permit/any unauthorized changes are made to the site/any unauthorized changes are made in the installation of the system. Improvement Permit is valid for 60 months from date of issuance.

Signed: Bruce Porter

Improvement Permit by: STEVE HEDRICK date 7-21-95

Existing System Inspection by: _____ date _____

Installed by: Jimmy Frye

Certificate of Completion by: _____ date _____

Operation Permit by: Brady Freeman / J.C. Moore date 2/15/96

HEALTH DEPT. COPY: WHITE INSPECTION COPY (FINAL): GREEN OWNER COPY (FINAL): YELLOW INSPECTION COPY (INITIAL): PINK OWNER COPY (INITIAL): GOLD