IREDELL COUNTY HEALTH DEPARTMENT

STATESVILLE 704-878-5305 MOORESVILLE 704-664-5281

IMPROVEMENT PERMIT / CERTIFICATE OF COMPLETION / OPERATION PERMIT / EXISTING SYSTEM INSPECTION

PROPERTY DESCRIPTION NO. ~~4571606053~~ DATE 10-26-96 TAX MAP NO. 4726721295 Watershed: ☐ Yes ☑ No

OWNER OR CONTRACTOR CRANDALL & O'BRIEN CONST. PHONE: Business 871-1536 Home

ADDRESS 310 TREEBARK ROAD, STATESVILLE, NC 28677

LOCATION NC 115 N TL SCOTTS CREEK RD, TR HAMPTON GLEN DRIVE, AT END ON LEFT

SUBDIVISION HAMPTON GLEN BLOCK / SECTION II LOT 8 LOT AREA 18,055.38 FT² SITE CLASS. PS DESIGN FLOW 360 L.T.A.R. 0.30 GPD/FT²

Septic Tank: 1000 Gallons; STB 1012 Date 3-8-97

Pump Tank: Gallons; PT Date

Pump Make: Model Serial No.

Nitrification Field: No Fields 1 Square Feet EQ TO 1200 Linear Feet 300+

No Lines FOUR Trench Width 36" Max Trench Bottom Depth 36" Gravel Depth N/A

☑ New System ☐ Repair System Type: I, II, III, IV, V, VI

System Description: CHAMBERED, GRAVITY

Repair System Description: PPBPS, PUMP/GRAV.

Maintenance Agreement Required: ☐ Yes ☑ No

☑ House/Mod. Home No. Bedrooms 3

☐ Mobile Home No. Bathrooms 2

☐ Business No. Employees

☐ Other


☐ Slab ☑ Crawl Space ☐ Basement w/plumbing ☐ Basement wo/plumbing

Water Supply: ☐ Individual ☐ Community ☑ Public


Comments: INSTALL 50 CHAMBERS IN FOUR LINES EXACTLY AS SHOWN

Comments:

INITIAL SITE SKETCH

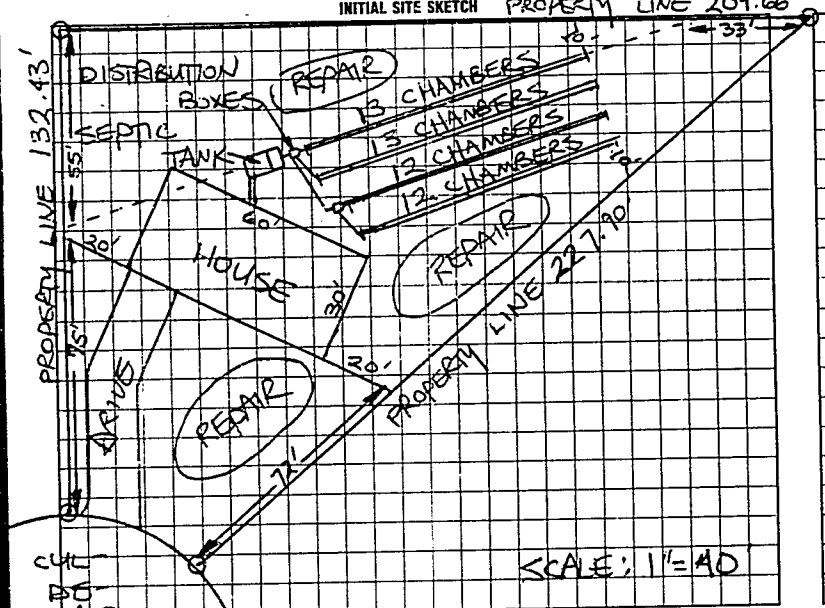

AS BUILT SKETCH

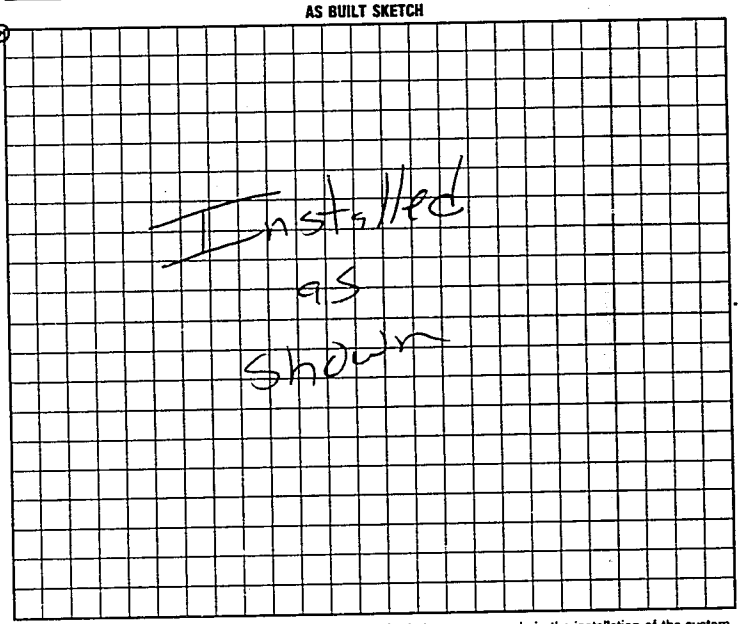

I understand that this permit can be suspended or revoked if any false information is supplied toward securing the permit/any unauthorized changes are made to the site/any unauthorized changes are made in the installation of the system.

IMPR. PERMIT TO CONST. IS VALID FOR A PERIOD EQUAL TO THE VALIDITY OF THE I.P. NOT TO EXCEED FIVE YEARS. I.P. W/SITE PLAN IS VALID FIVE YEARS, H-1 Bachelor

Signed:

Improvement Permit by: STEVE HEDRICK date 10-26-96

Authorization to Construct: STEVE HEDRICK date 10-26-96

Existing System Inspection by:

Installed by: date

~~Certificate of Completion by:~~

Operation Permit by: Mark C. Witt RS date 5-8-97

HEALTH DEPT. COPY: WHITE INSPECTION COPY (FINAL): GREEN OWNER COPY (FINAL): YELLOW INSPECTION COPY (INITIAL): PINK OWNER COPY (INITIAL): GOLD

8 2 0 0 0