mb #46994 (150.00)

IREDELL COUNTY HEALTH DEPARTMENT

STATESVILLE 704-878-5305 MOORESVILLE 704-664-5281

IMPROVEMENT PERMIT / CERTIFICATE OF COMPLETION / OPERATION PERMIT / EXISTING SYSTEM INSPECTION

PROPERTY DESCRIPTION NO. 24093 DATE 7-24-96 TAX MAP NO. 9A-A-34 (PART) Watershed: ☐ Yes ☒ No

OWNER OR CONTRACTOR CRANDALL & O'BRIEN PHONE: Business Home 871-1536

ADDRESS 310 TREEBARK ROAD STATESVILLE NC 28677

LOCATION NC 115 N, TL SCOTTS CREEK RD, TL HAMPTON GLEN DR, 7TH LOT ON LEFT

SUBDIVISION HAMPTON GLEN BLOCK / SECTION II LOT 7 LOT AREA 15,116.10 FT² SITE CLASS. PS DESIGN FLOW 360 L.T.A.R. 0.3 GPD/FT²

Septic Tank: 1000 Gallons; STB 794 Date 4-23-96
Pump Tank: ____ Gallons; PT ____ Date ____
Pump Make: ____ Model ____ Serial No. ____
Nitrification Field: No Fields 1 Square Feet EQ. TO 1200 Linear Feet 200'+
No Lines 5 Trench Width 36" Max Trench Bottom Depth 36"

☒ New System ☐ Repair System Type: I, II, ☒ III, IV, V, VI
System Description: CHAMBERED GRAVITY
Repair System Description: PPBPS, PUMP FED
Maintenance Agreement Required: ☐ Yes ☒ No
Gravel Depth N/A


☒ House/Mod. Home No. Bedrooms 3
☐ Mobile Home No. Bathrooms 2
☐ Business No. Employees ____
☐ Other ____
☐ Slab ☒ Crawl Space ☐ Basement w/plumbing ☐ Basement wo/plumbing

Water Supply: ☐ Individual ☐ Community ☒ Public

Comments: (1) TRENCH SIDEWALLS TO BE SCARIFIED WITH HANDTOOL OR BACKHOE & TO BE INSPECTED PRIOR TO INSTALLING CHAMBERS (2) INSTALL 50 CHAMBERS IN FIVE LINES AS SHOWN,

Comments:

INITIAL SITE SKETCH SCALE 1" = 30'

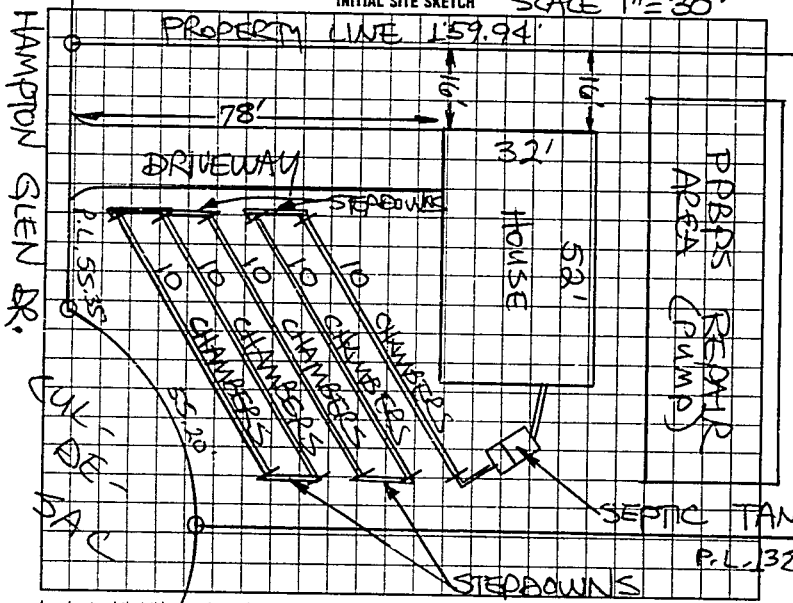

AS BUILT SKETCH

SYSTEM INSTALLED ACCORDING TO INITAL SITE SKETCH

I understand that this permit can be suspended or revoked if any false information is supplied toward securing the permit/any unauthorized changes are made to the site/any unauthorized changes are made in the installation of the system.

AUTH. TO CONST. IS VALID FIVE YEARS FROM DATE OF ISSUANCE. IMPROVEMENT PERMIT W/SITE PLAN IS VALID FOR FIVE YEARS

Signed: Dick Crandall Installed by: A-1 BACKHOE

Improvement Permit by: STEVE HEDRICK date 7-24-96
Authorization to Construct by: STEVE HEDRICK date 7-24-96
Certificate of Completion by: ____ date ____
Operation Permit by: STEVE HEDRICK date 9-5-96

HEALTH DEPT. COPY: WHITE | INSPECTION COPY (FINAL): GREEN | OWNER COPY (FINAL): YELLOW | INSPECTION COPY (INITIAL): PINK | OWNER COPY (INITIAL): GOLD

890500