IREDELL COUNTY HEALTH DEPARTMENT

STATESVILLE 704-878-5305 MOORESVILLE 704-664-5281

IMPROVEMENT PERMIT / CERTIFICATE OF COMPLETION / OPERATION PERMIT / EXISTING SYSTEM INSPECTION

PROPERTY DESCRIPTION NO. 24326 072553 DATE 11-30-96 TAX MAP NO. 9A-A-34 (PART) Watershed: ☐ Yes ☑ No

OWNER OR CONTRACTOR CRANDALL & O'BRIEN CONST. PHONE: Business 871-1536 Home

ADDRESS 310 TREEBARK ROAD, STATESVILLE, NC 28677

LOCATION NC 115N TL SCOTTS CREEK RD TL HAMPTON GLEN DRIVE, 3RD LOT ON LEFT

SUBDIVISION HAMPTON GLEN BLOCK / SECTION II LOT 3 LOT AREA 100'X159' SITE CLASS. PS DESIGN FLOW 360 L.T.A.R. 0.30 GPD/SQ FT

Septic Tank: 1000 Gallons; STB 1012 Date 5-2-98

Pump Tank: Gallons; PT Date

Pump Make: Model Serial No.

Nitrification Field: No Fields 1 Square Feet Eq. To 1200 Linear Feet 3007

No Lines FOUR Trench Width 36" Max Trench Bottom Depth 36" Gravel Depth N/A

☑ New System ☐ Repair System Type: I, II, ☑ III, IV, V, VI

System Description: CHAMBERED GRAVITY

Repair System Description: PPRPS, PUMP

Maintenance Agreement Required: ☐ Yes ☑ No

☑ House/Mod. Home ☐ Mobile Home ☐ Business ☐ Other

No. Bedrooms 3 No. Bathrooms 2 No. Employees


☐ Slab ☑ Crawl Space ☐ Basement w/plumbing ☐ Basement wo/plumbing

Water Supply: ☐ Individual ☐ Community ☑ Public


Comments: ① STUB-OUT PLUMBING AS SHALLOW AS POSSIBLE.
② INSTALL 50 CHAMBERS IN FOUR LINES AS SHOWN.
③ RAKE TRENCH SIDEWALLS WHERE SMEARING OCCURS.

Comments:
* Note Tank at Back of house due to stubout of plumbing.

SCALE: 1"=30' INITIAL SITE SKETCH

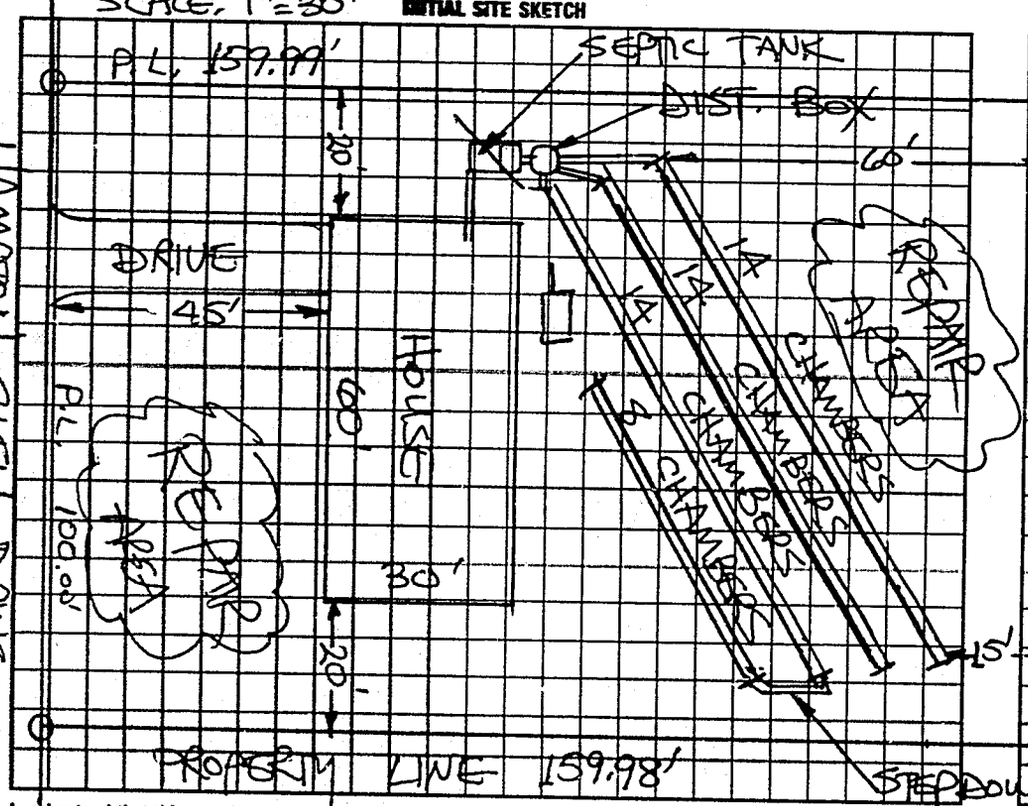

AS BUILT SKETCH

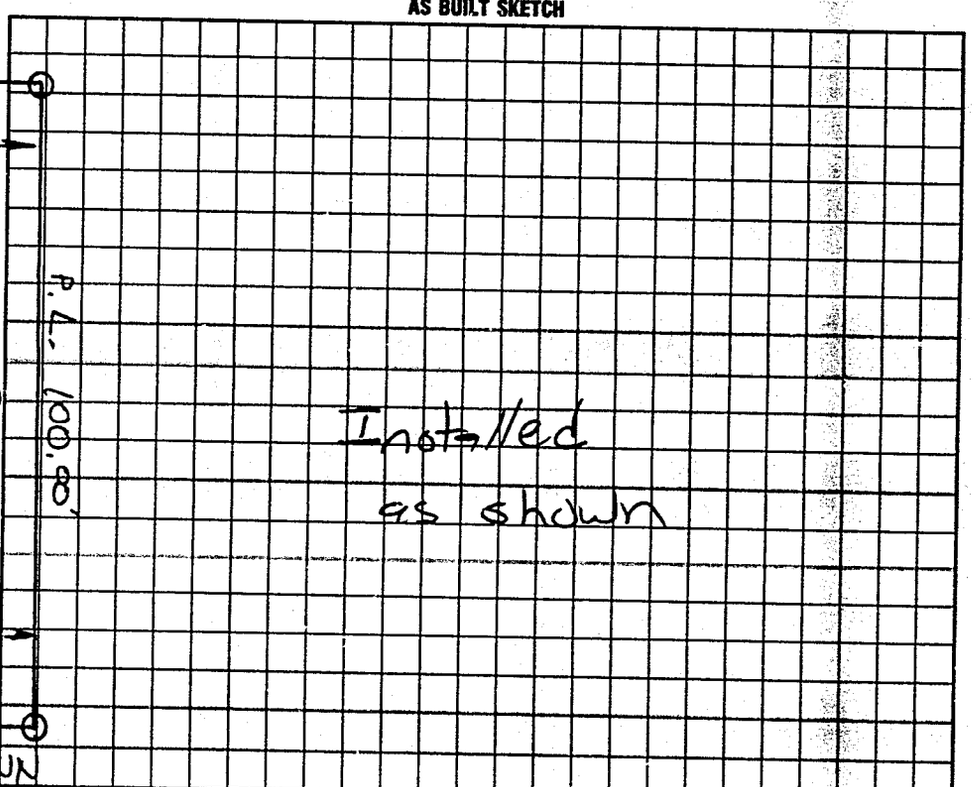

I understand that this permit can be suspended or revoked if any false information is supplied toward securing the permit/any unauthorized changes are made to the site/any unauthorized changes are made in the installation of the system.

Auth. to Const. is valid for a period equal to the validity of the IP not to exceed five years. IP w/site plan is valid five years.

Signed:

Improvement Permit by: STEVE HEDRICK date 11-30-96

Authorization to Construct

XXX Existing System Inspection by: STEVE HEDRICK date 11-30-96

Installed by: A-1 Backhoe

Certificate of Completion by: date

Operation Permit by: Mary Coats RS date 12-1-98

HEALTH DEPT. COPY: WHITE INSPECTION COPY (FINAL): GREEN OWNER COPY (FINAL): YELLOW INSPECTION COPY (INITIAL): PINK OWNER COPY (INITIAL): GOLD