61521

IREDELL COUNTY HEALTH DEPARTMENT

STATESVILLE 704-878-5305 MOORESVILLE 704-664-5281

IMPROVEMENT PERMIT / CERTIFICATE OF COMPLETION / OPERATION PERMIT / EXISTING SYSTEM INSPECTION

PROPERTY DESCRIPTION NO. 23660 DATE 5-18-96 TAX MAP NO. 9A-A-34 (PART) Watershed: ☐ Yes ☒ No

OWNER OR CONTRACTOR CRANDALL & O'BRIEN CONST. PHONE: Business 871-1536 Home

ADDRESS 310 TREEBARK ROAD STATESVILLE NC 28677

LOCATION NC 115 N TO SCOTTS CREEK RD LOT ON LEFT AT HAMPTON GLEN DRIVE

SUBDIVISION HAMPTON GLEN BLOCK / SECTION I LOT 1 LOT AREA 18,492 FT² SITE CLASS PS DESIGN FLOW 360 L.T.A.R. 0.30 GPD/FT²

Septic Tank: 1000 Gallons; STB 1194 Date 7-10-

Pump Tank: _____ Gallons; PT _____ Date _____

Pump Make: _____ Model _____ Serial No. _____

Nitrification Field: No Fields 1 Square Feet 1200 Linear Feet 400

No Lines 4 Trench Width 36" Max Trench Bottom Depth 18-36" Gravel Depth 12"

☒ New System ☐ Repair System Type: I, II, III, IV, V, VI

System Description: CONVENTIONAL GRAVITY

Repair System Description: CHAMBERED GRAVITY

Maintenance Agreement Required: ☐ Yes ☒ No

☒ House/Mod. Home No. Bedrooms 3

☐ Mobile Home No. Bathrooms 2

☐ Business No. Employees _____

☐ Other _____


☐ Slab ☒ Crawl Space ☐ Basement w/plumbing ☐ Basement wo/plumbing

Water Supply: ☐ Individual ☐ Community ☒ Public


Comments: STUB-OUT PLUMBING ABOVE FOOTINGS TO KEEP SYSTEM AS SHALLOW AS POSSIBLE

Comments:

INITIAL SITE SKETCH

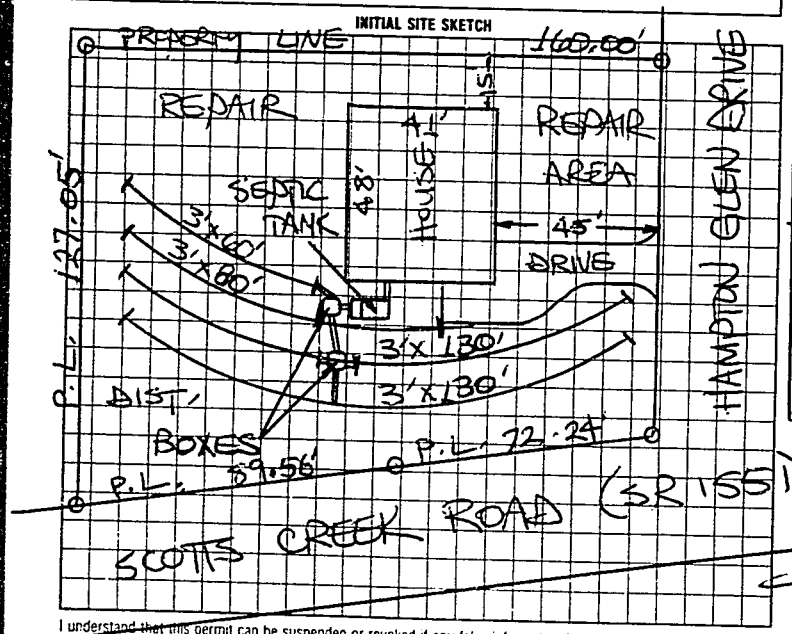

AS-BUILT SKETCH

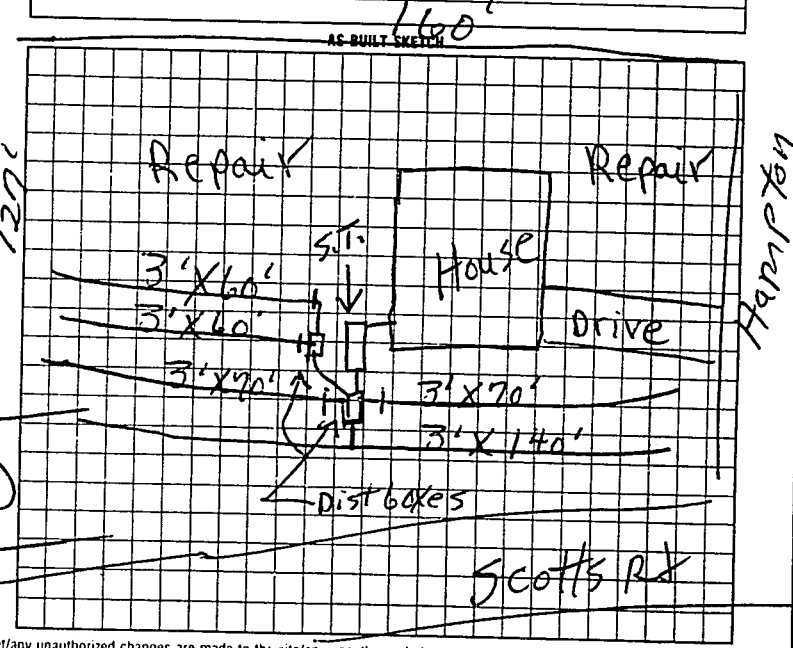

I understand that this permit can be suspended or revoked if any false information is supplied toward securing the permit/any unauthorized changes are made to the site/any unauthorized changes are made in the installation of the system.

Authorization to Construct is valid five (5) years from date of issuance. Improvement Permit has no expiration date.

Signed: _____

Improvement Permit by STEVE HEDRICK date 5-18-96

Existing System Inspection by STEVE HEDRICK date 5-18-96

AUTHORIZATION TO CONSTRUCT:

Installed by A-1 Backhoe

Certificate of Completion by: _____ date _____

Operation Permit by P. C. Moore date 10-3-96

HEALTH DEPT COPY WHITE INSPECTION COPY (FINAL) GREEN OWNER COPY (FINAL) YELLOW INSPECTION COPY (INITIAL) PINK