IREDELL COUNTY HEALTH DEPARTMENT

STATESVILLE 704-878-5305 MOORESVILLE 704-664-5281

IMPROVEMENT PERMIT / AUTHORIZATION TO CONSTRUCT / OPERATION PERMIT / EXISTING SYSTEM INSPECTION

PERMIT# 083207 PIN# 4726 82 3288 (PT) DATE 9-1-99

OWNER OR CONTRACTOR SAMUEL SCOTT PHONE Business 873-1391 Home

ADDRESS 2278 S. CHARLEY FORD STATESVILLE, NC 28625

LOCATION NC115 N TL SCOTTS CREEK, TL MILLER FARM, TL GLEN CROSS, 2ND LOT ON RIGHT

SUBDIVISION CROSS CREEK BLOCK / SECTION II LOT 35 LOT AREA 15,000 SF SITE CLASS PS DESIGN FLOW 360 L.T.A.R. 0.33 GPD/FT2

Septic Tank: 1000 Gallons; STB 1012 Date 8-22-99
Pump Tank: Gallons; PT Date
Pump Make: Model Serial No.
Nitrification Field: No Fields 1 Square Feet 1080 Linear Feet 360
No Lines FIVE Trench Width 36" Max Trench Bottom Depth 36" Gravel Depth 12"

☑ New System ☐ Repair System Type: I II III IV V VI
System Description: CONVENTIONAL GRAVITY
Repair System Description: 50% REDUCTION GRAVITY
Maintenance Agreement Required: ☐ Yes ☑ No
☐ Slab ☑ Crawl Space ☐ Basement w/plumbing ☐ Basement wo/plumbing


☑ House/Mod. Home No. Bedrooms 3
☐ Mobile Home No. Bathrooms 2
☐ Business No. Employees
☐ Other

Water Supply:
☐ Individual
☐ Public
☐ Community

Comments/Conditions: KEEP SYSTEM MINIMUM 10 FEET FROM WATER LINE

Comments/Conditions: SEPTIC TANK WITH RISERS INSTALLED USING "POLY LOK" FILTER

INITIAL SITE SKETCH

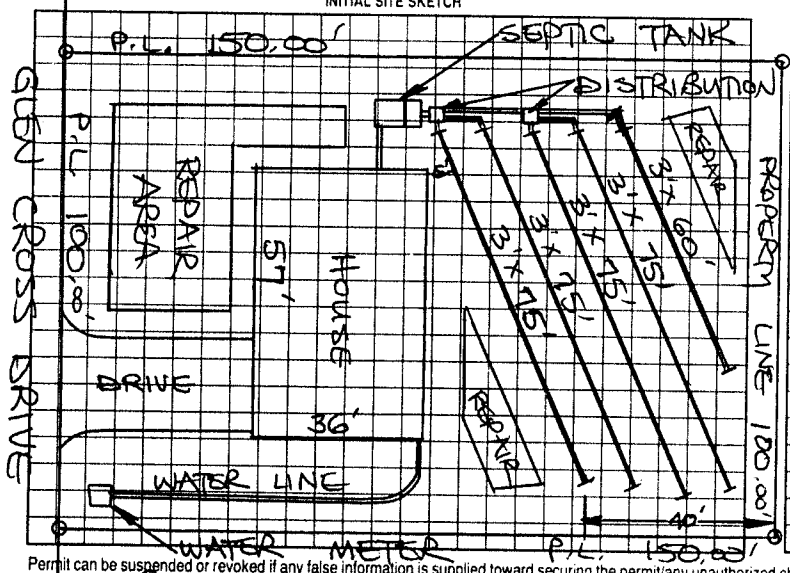

AS BUILT SKETCH

BOXES (2)

SYSTEM INSTALLED ACCORDING TO INITAL SITE SKETCH

Permit can be suspended or revoked if any false information is supplied toward securing the permit/any unauthorized changes are made to the site/any unauthorized changes are made in the installation of the system. Improvement Permit with plat valid without expiration. Improvement Permit with site plan valid for sixty months. Authorization to Construct is valid for a period equal to that of Improvement Permit – not to exceed sixty months.

Signed: Paul Scott date 9-1-99

Improvement Permit by: STEVE HEDRICK date 9-1-99

Authorization to Construct by: STEVE HEDRICK date 9-1-99

Installed by: DAVID YOUNTZ

Operation Permit by: STEVE HEDRICK date 11-12-99

Existing System Inspection by: date

HEALTH DEPT COPY: WHITE OWNER COPY (FINAL) YELLOW OWNER COPY (INITIAL) PINK