IREDELL COUNTY HEALTH DEPARTMENT

STATESVILLE 704-878-5305 (a) MOORESVILLE 704-664-5281

IMPROVEMENT PERMIT / AUTHORIZATION TO CONSTRUCT / OPERATION PERMIT / EXISTING SYSTEM INSPECTION

PERMIT# 095368 PIN# 4726729209 DATE 5/21/01

OWNER OR CONTRACTOR Samuel G. Scott PHONE: Business (704) 873-1391 Home —

ADDRESS 2278 S. Chipley Ford Drive Statesville, N.C. 28625

LOCATION 115 N. (L) Scotts Creek Rd. (L) Miller Farm (L) Glen Cross Drive Corner Lot on Left

SUBDIVISION Cross Creek BLOCK / SECTION II LOT 24 LOT AREA .46 Acres SITE CLASS. PS DESIGN FLOW 360 L.T.A.R. .3

Septic Tank: 1000 Gallons; STB 1012 Date 7-24-04
Pump Tank: Gallons; PT Date
Pump Make: Model Serial No.
Nitrification Field: No Fields 1 Square Feet equivalent to 1200 Linear Feet 300
No Lines 6 Trench Width 36" Max Trench Bottom Depth 30" Gravel Depth —

[X] New System ☐ Repair System Type: I, II, (III), IV, V, VI
System Description: Gravity, 25% Reduction
Repair System Description: Gravity, 50% Reduction
Maintenance Agreement Required: ☐ Yes [X] No

[X] House/Mod. Home No. Bedrooms 3
☐ Mobile Home No. Bathrooms 2
☐ Business No. Employees
☐ Other


☐ Slab [X] Crawl Space ☐ Basement w/plumbing ☐ Basement wo/plumbing

Water Supply: ☐ Individual [X] Public ☐ Community

Comments:/Conditions: (1) Install lines on contour (2) 25% Reduction using (1) one flow divider + (2) two dist. boxes (3) Use either Chambers or HDES Sections

Comments:/Conditions: SEPTIC TANK WITH MARKER INSTALLED USING "POLYLOK" FILTER

INITIAL SITE SKETCH

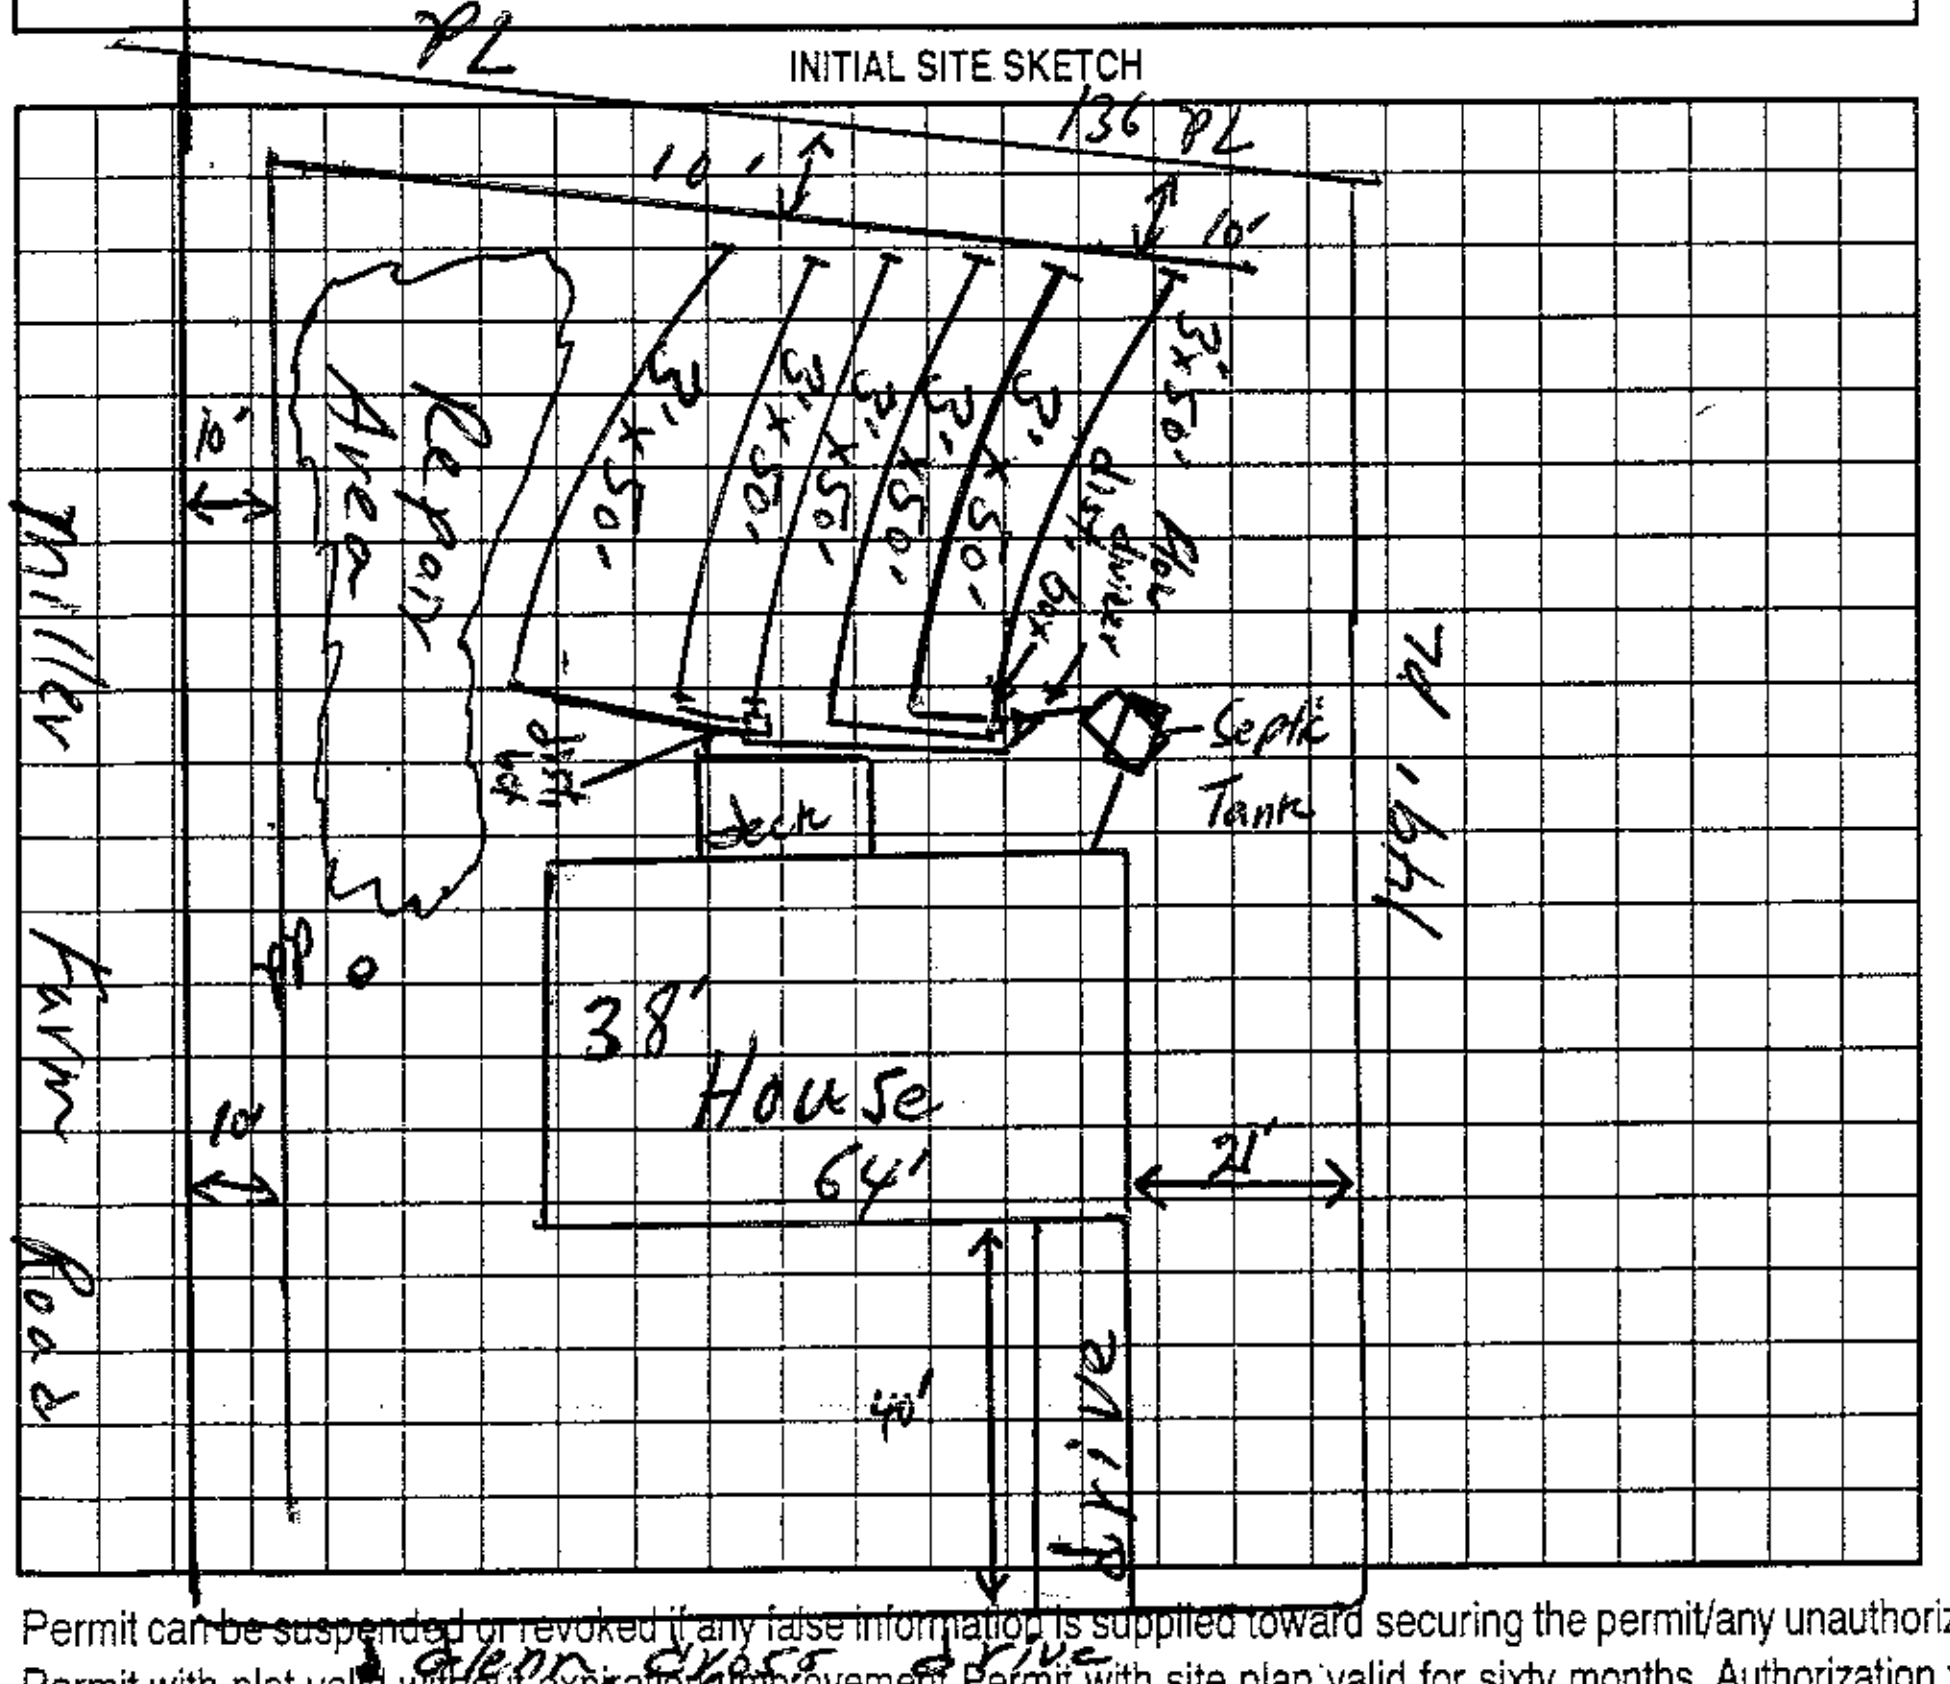

AS BUILT SKETCH

SYSTEM INSTALLED ACCORDING TO INITIAL SITE SKETCH

Permit can be suspended or revoked if any false information is supplied toward securing the permit/any unauthorized changes are made to the site/any unauthorized changes are made in the installation of the system. Improvement Permit with plat valid without expiration/Improvement Permit with site plan valid for sixty months. Authorization to Construct is valid for a period equal to that of Improvement Permit – not to exceed sixty months.

Signed: Samuel G. Scott date 6-25-01
Improvement Permit by: William O. Johnson date 5/21/01
Authorization to Construct by: William O. Johnson date 5/21/01

Installed by: DAVID YOUNTZ
Operation Permit by: STEVE HEDRICK date 2-7-05
Existing System Inspection by: date

HEALTH DEPT. COPY: WHITE OWNER COPY (FINAL): YELLOW OWNER COPY (INITIAL): PINK