IREDELL COUNTY HEALTH DEPARTMENT

STATESVILLE 704-878-5305 MOORESVILLE 704-664-5281

IMPROVEMENT PERMIT / AUTHORIZATION TO CONSTRUCT / OPERATION PERMIT / EXISTING SYSTEM INSPECTION

PERMIT# 91790 PIN# 4726729424 DATE 9-19-00

OWNER OR CONTRACTOR Samuel G Scotts PHONE: Business Home 873 1391

ADDRESS 2278 S Chipley Ford Rd Statesville N.C.

LOCATION 115 N TL Scotts Creek Rd TL Miller Fm TL cross creek 1st lot rt.

SUBDIVISION Crosscreek BLOCK / SECTION 2 LOT 23 LOT AREA .53 acres SITE CLASS PS DESIGN FLOW 360 L.T.A.R. .3 gal/sq ft/day

Septic Tank: 1000 Gallons; STB 1012 Date 12-31-00
Pump Tank: Gallons; PT Date
Pump Make: Model Serial No.
Nitrification Field: No. Fields 1 Square Feet 1200 Linear Feet 400
No. Lines 4 Trench Width 36" Max Trench Bottom Depth 26" Gravel Depth 12"

☑ New System ☐ Repair System Type: I II III IV V VI
System Description: Conv. Gravity
Repair System Description: 25% Reduction
Maintenance Agreement Required: ☐ Yes ☑ No
☐ Slab ☑ Crawl Space ☐ Basement w/plumbing ☐ Basement wo/plumbing


☑ House/Mod. Home No. Bedrooms 3
☐ Mobile Home No. Bathrooms 2
☐ Business No. Employees
☐ Other

Water Supply: ☐ Individual ☑ Public ☐ Community


Comments/Conditions:

Comments/Conditions – Poly Lok Filter Installed
– Septic Tank Risers Installed

INITIAL SITE SKETCH

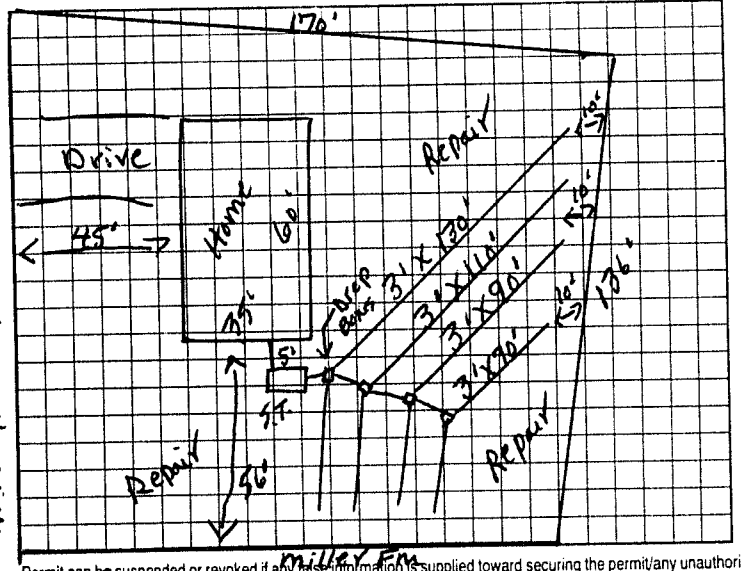

AS BUILT SKETCH

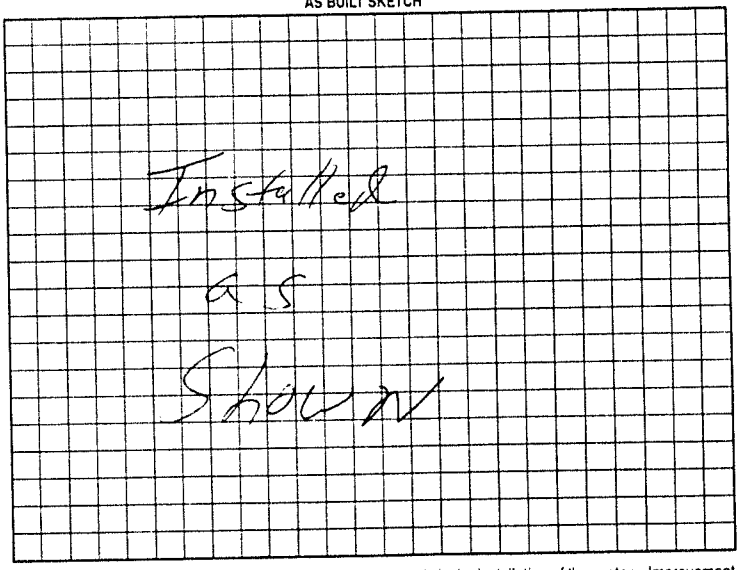

Cross Creek Drive

Permit can be suspended or revoked if any false information is supplied toward securing the permit/any unauthorized changes are made to the site/any unauthorized changes are made in the installation of the system. Improvement Permit with plat valid without expiration. Improvement Permit with site plan valid for sixty months. Authorization to Construct is valid for a period equal to that of Improvement Permit – not to exceed sixty months.

Signed: Samuel G Scott date 10-3-00 Installed by: David Yountz

Improvement Permit by: P. C. Moore date 9-19-00 Operation Permit by: William O. Johnson date 6/28/01

Authorization to Construct by: P. C. Moore date 9-19-00 Existing System Inspection by: date

HEALTH DEPT. COPY WHITE OWNER COPY (FINAL) YELLOW OWNER COPY (INITIAL) PINK