IREDELL COUNTY HEALTH DEPARTMENT

THIS PERMIT VOIDS PREVIOUS ISSUED 5-29-96 #61133

STATESVILLE 704-878-5305 MOORESVILLE 704-664-5281 61133

IMPROVEMENT PERMIT / CERTIFICATE OF COMPLETION / OPERATION PERMIT / EXISTING SYSTEM INSPECTION

PROPERTY DESCRIPTION NO. 23786 DATE 10-15-96 TAX MAP NO. 9A-8-A-37

OWNER OR CONTRACTOR TIM HOPE PHONE: Business Watershed: ☐ Yes ☒ No

ADDRESS P.O. BOX 5882 STATESVILLE NC 28677 Home 881-1944

LOCATION NC 115 N TL SCOTTS CREEK TR BROOKHOLLOW 6TH LOT ON LEFT

SUBDIVISION BROOKHOLLOW BLOCK / SECTION LOT 37 LOT AREA 100'x150' SITE CLASS. PS DESIGN FLOW 360 L.T.A.R. 0.4 GPD/FT²

Septic Tank: 1000 Gallons; STB Date

Pump Tank: Gallons; PT Date

Pump Make: Model Serial No.

Nitrification Field: No Fields 1 Square Feet 900 Linear Feet 228

No Lines THREE Trench Width 36" Max Trench Bottom Depth 36" Gravel Depth N/A

☒ New System ☐ Repair System Type: I, II, III, IV, V, VI

System Description: CHAMBERED GRUNTY

Repair System Description: CHAMBER PUMP/CERTIFY

Maintenance Agreement Required: ☐ Yes ☒ No

☒ House/Mod. Home No. Bedrooms 3

☐ Mobile Home No. Bathrooms 2

☐ Business No. Employees

☐ Other


☐ Slab ☒ Crawl Space ☐ Basement w/plumbing ☐ Basement wo/plumbing

Water Supply: ☐ Individual ☐ Community ☒ Public


Comments:

Comments:

INITIAL SITE SKETCH

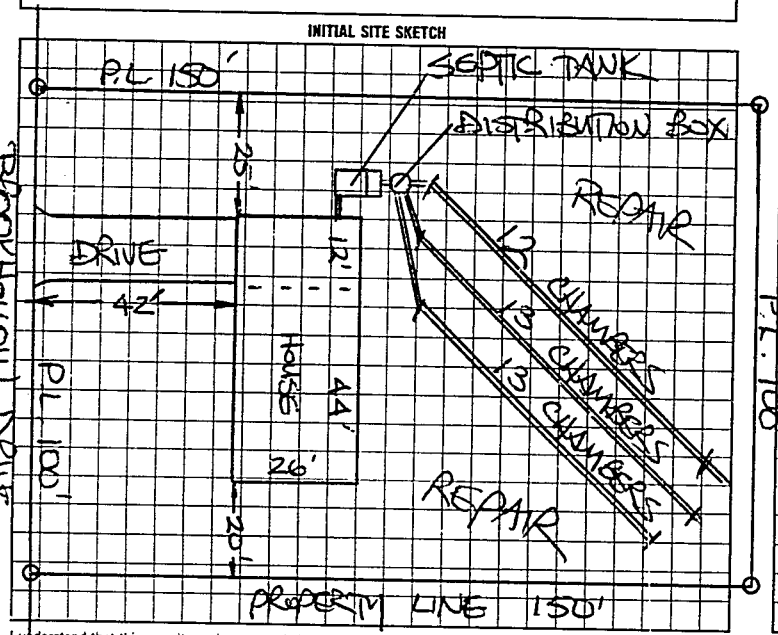

AS BUILT SKETCH

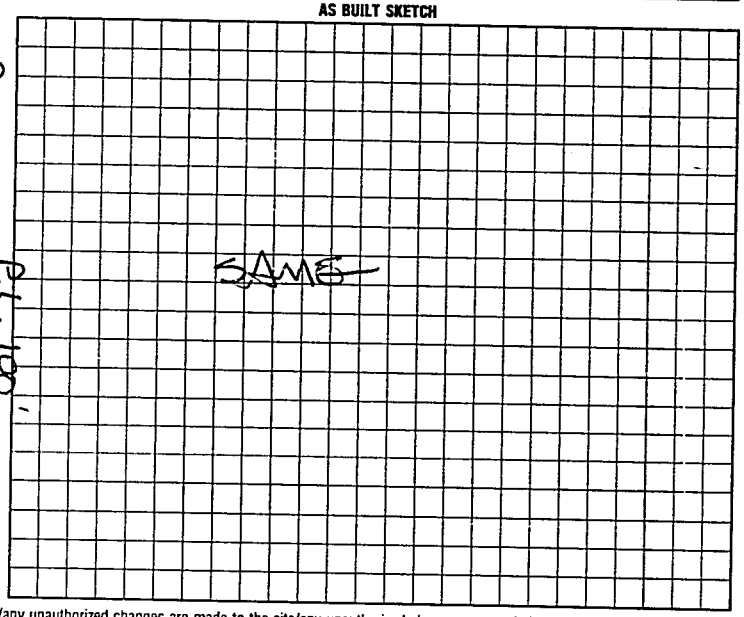

I understand that this permit can be suspended or revoked if any false information is supplied toward securing the permit/any unauthorized changes are made to the site/any unauthorized changes are made in the installation of the system.

Signed: Timothy P Hope

Improvement Permit by: STEVE HENDRICK date 10-15-96

Existing System Inspection by: STEVE HENDRICK date 10-15-96

Installed by: ANDY DANIELS

Certificate of Completion by: date

Operation Permit by: date 10-18-96

HEALTH DEPT. COPY: WHITE INSPECTION COPY (FINAL): GREEN OWNER COPY (FINAL): YELLOW INSPECTION COPY (INITIAL): PINK OWNER COPY (INITIAL): GOLD