IREDELL COUNTY HEALTH DEPARTMENT

STATESVILLE 704-878-5305 MOORESVILLE 704-664-5281

54482

IMPROVEMENT PERMIT / CERTIFICATE OF COMPLETION / OPERATION PERMIT / EXISTING SYSTEM INSPECTION

PROPERTY DESCRIPTION NO. 20203 DATE 2/1/95 TAX MAP NO. 9A-8-A-38

OWNER OR CONTRACTOR HOPE BROTHERS PHONE: Business Watershed: ☐ Yes ☒ No

ADDRESS 1120 BARKLEY ROAD STATESVILLE NC 28677 Home 872-4111

LOCATION NC 115N TL SCOTTS CREEK ROAD TR BROOK HOLLOW DRIVE 7TH LOT ON (LEFT)

SUBDIVISION BROOK HOLLOW BLOCK / SECTION LOT 38 LOT AREA 100' x 150' SITE CLASS. PS DESIGN FLOW 360 L.T.A.R. .40 GPD/FT²

Septic Tank: 1000 Gallons; STB 1012 Date 4-26-95

Pump Tank: Gallons; PT Date

Pump Make: Model EQUIVALENT Serial No. 225

Nitrification Field: No Fields 1 Square Feet 900 Linear Feet 300

No Lines 5' Trench Width 36" Max Trench Bottom Depth 18-36" Gravel Depth 12"

☒ New System ☐ Repair System Type: I, II, III, IV, V, VI

System Description: CONVENTIONAL GRAVITY

Repair System Description: CONV. GRAVITY

Maintenance Agreement Required: ☐ Yes ☒ No

☒ House/Mod. Home No. Bedrooms 3

☐ Mobile Home No. Bathrooms 2

☐ Business No. Employees

☐ Other


☐ Slab ☐ Crawl Space ☐ Basement w/plumbing ☒ Basement wo/plumbing

Water Supply: ☐ Individual ☐ Community ☒ Public


Comments: ① KEEP SYSTEM MINIMUM 15' FROM BASEMENT DRAIN 10' FROM PROPERTY LINE ② INSTALL LINES ON CONTOUR, NO DEEPER THAN 36", 9' APART O.C.

Comments: ① CHAMBERED SYSTEM INSTALLED AT CONTRACTORS REQUEST. ② 38 CHAMBERS INSTALLED AS SHOWN

INITIAL SITE SKETCH

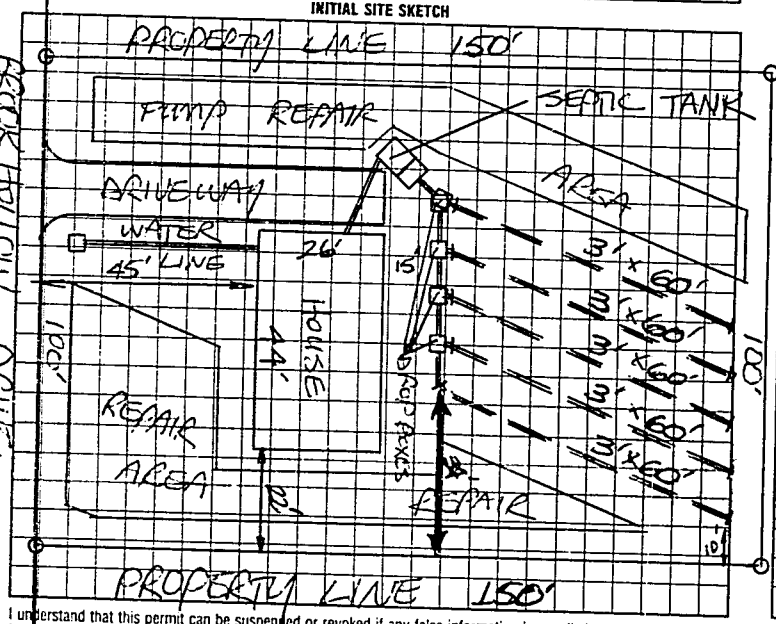

AS BUILT SKETCH

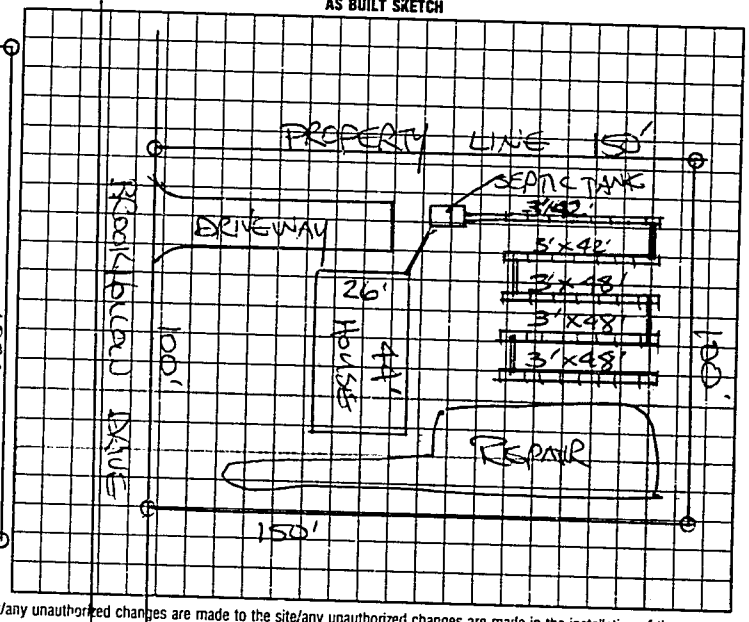

I understand that this permit can be suspended or revoked if any false information is supplied toward securing the permit/any unauthorized changes are made to the site/any unauthorized changes are made in the installation of the system. Improvement Permit is valid for 60 months from date of issuance.

Signed: Jody Hyk

Improvement Permit by: STEVE HEDRICK date 2/1/95

Existing System Inspection by: date

Installed by: ARNIE DUNCAN

Certificate of Completion by: ~~STEVE HEDRICK~~ date ~~4-27-95~~

Operation Permit by: STEVE HEDRICK date 7-27-95

HEALTH DEPT. COPY: WHITE INSPECTION COPY (FINAL): GREEN OWNER COPY (FINAL): YELLOW INSPECTION COPY (INITIAL): PINK OWNER COPY (INITIAL): GOLD

8 1 2 0 0 0