IREDELL COUNTY HEALTH DEPARTMENT

50

62098

STATESVILLE 704-878-5305 MOORESVILLE 704-664-5281

IMPROVEMENT PERMIT / CERTIFICATE OF COMPLETION / OPERATION PERMIT / EXISTING SYSTEM INSPECTION

PROPERTY DESCRIPTION NO. 237-87-~~0062098~~ DATE 7-20-96 TAX MAP NO. 9A-8-A-41

OWNER OR CONTRACTOR TIM HOPE PHONE: Business Home 881-1944 Watershed: ☐ Yes ☒ No

ADDRESS P.O. BOX 5882, STATESVILLE NC 28677

LOCATION N^2 115N TL SCOTTS CREEK, TR BROOKHOLLOW, TL BOWMAN, 1ST LOT ON LEFT

SUBDIVISION BROOKHOLLOW BLOCK / SECTION LOT 41 LOT AREA LIMITED SITE CLASS. PS DESIGN FLOW 360 L.T.A.R. 0.40 GPD/FT²

Septic Tank: 1000 Gallons; STB 794 Date 12-19-97

Pump Tank: Gallons; PT Date

Pump Make: Model Serial No.

Nitrification Field: No Fields 1 Square Feet 600 TO 900 Linear Feet 225+

No Lines 4 Trench Width 36 Max Trench Bottom Depth 24-36" Gravel Depth N/A

☒ New System ☐ Repair System Type: I, II, III, IV, V, VI

System Description: CHAMBERED GRAVITY

Repair System Description: CHAMBERED PUMP

Maintenance Agreement Required: ☐ Yes ☒ No

☒ House/Mod. Home ☐ Mobile Home ☐ Business ☐ Other

No. Bedrooms 3 No. Bathrooms 2 No. Employees


☐ Slab ☒ Crawl Space ☐ Basement w/plumbing ☐ Basement wo/plumbing

Water Supply: ☐ Individual ☐ Community ☒ Public


Comments: ① INSTALL 38 CHAMBERS IN FOUR LINES AS SHOWN USING SERIAL DISTRIBUTION ② KEEP SYSTEM MINIMUM 5' FROM HOUSE, 10' FROM PROPERTY LINE, & 10' FROM WATER LINE

Comments:

INITIAL SITE SKETCH

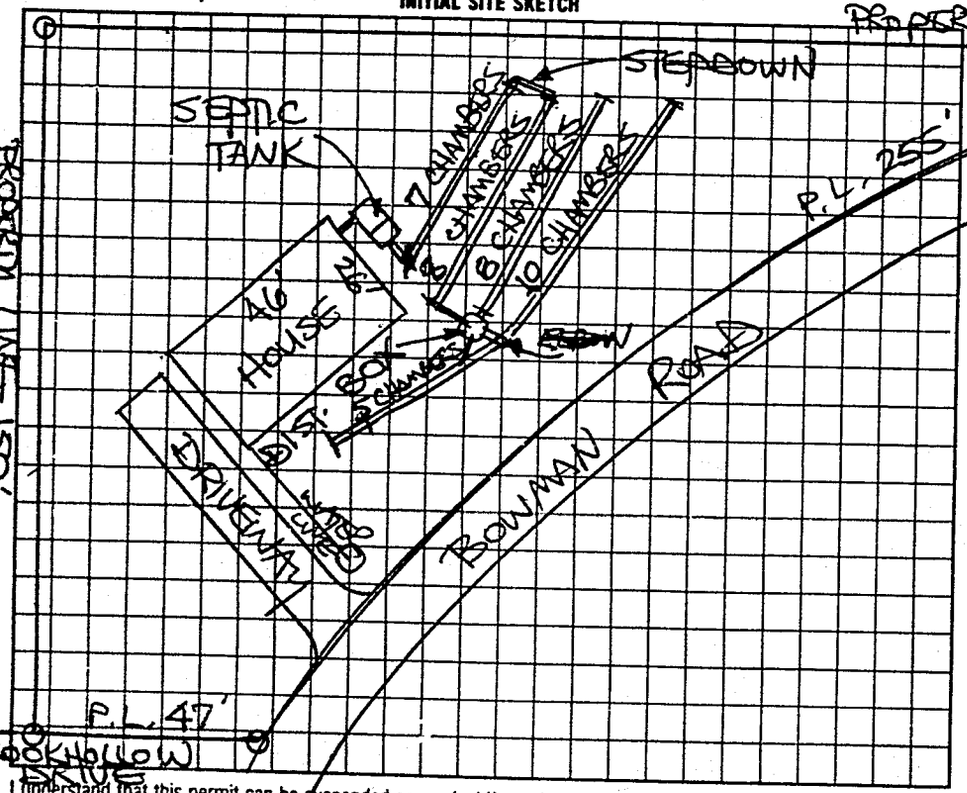

AS BUILT SKETCH

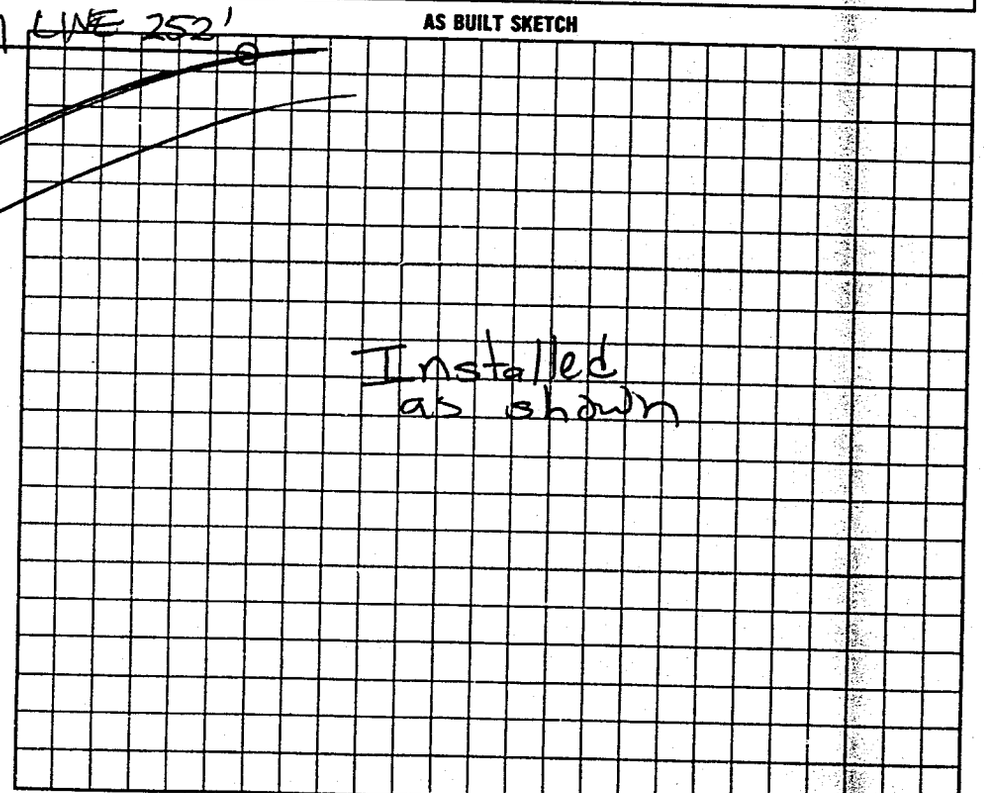

I understand that this permit can be suspended or revoked if any false information is supplied toward securing the permit/any unauthorized changes are made to the site/any unauthorized changes are made in the installation of the system.

Authorization to Construct is valid five (5) years from date of issuance. Improvement Permit has no expiration date.

Signed: Timothy J. Hope

Improvement Permit by: STEVE HEDRICK date 7-20-96

Existing System Inspection by: STEVE HEDRICK date 7-20-96

Installed by: James Huddler

~~Certificate of Completion by:~~ date

Operation Permit by: Matt Coff RS date 5-6-98

AUTHORIZATION TO CONSTRUCT: APPLICANT COPY (WHITE) INSPECTION COPY (FINAL) GREEN OWNER COPY (FINAL): YELLOW INSPECTION COPY (INITIAL): PINK OWNER COPY (INITIAL) GOLD