48259

IREDELL COUNTY HEALTH DEPARTMENT

STATESVILLE 704-878-5305 MOORESVILLE 704-664-5281

IMPROVEMENT PERMIT / CERTIFICATE OF COMPLETION / OPERATION PERMIT / EXISTING SYSTEM INSPECTION

PROPERTY DESCRIPTION NO. 16755 DATE 8/4/93 TAX MAP NO 96-A-31

OWNER OR CONTRACTOR LARRY BROWN PHONE Business Home 873-0020

ADDRESS RT. 7 BOX 691 STATESVILLE, NC 28677

LOCATION NC 115 N, FL MERRIMAN ROAD, TL 1ST ROAD, 1ST MH ON (L)

SUBDIVISION BROWN MHP BLOCK / SECTION LOT #1 LOT AREA LIMITED SITE CLASS PS L.T.A.R

Water Supply: ~~Private~~ ✓Community Public WELL

Septic Tank: EXISTING Gallons: STB Date

Pump Tank: Gallons: PT Date

Nitrification Field: No Fields 1 Square Feet Linear Feet EXISTING

No Lines Trench Width Trench Depth Gravel Depth 12"

☐ New System ☐ Repair System Type: I (II) III IV V VI

System Description: CONV. GRAVITY

Repair System Description:

Maintenance Agreement Required: ☐ Yes ~~No~~

~~House/Mod. Home~~ Mobile Home Business Other

No. Bedrooms 2 No. Bathrooms 2 No. Employees

Slab ~~Crawl Space~~ Basement w/plumbing Basement wo/plumbing

Garbage Disposal: ☐ Yes ~~No~~

Auto. Dishwasher: ~~Yes~~ ☐ No


Auto. Washing Machine: ✓ Yes ☐ No

Other Other

Comments UNIT ON SITE AT TIME of INSPECTION

INITIAL SITE SKETCH

AS BUILT SKETCH

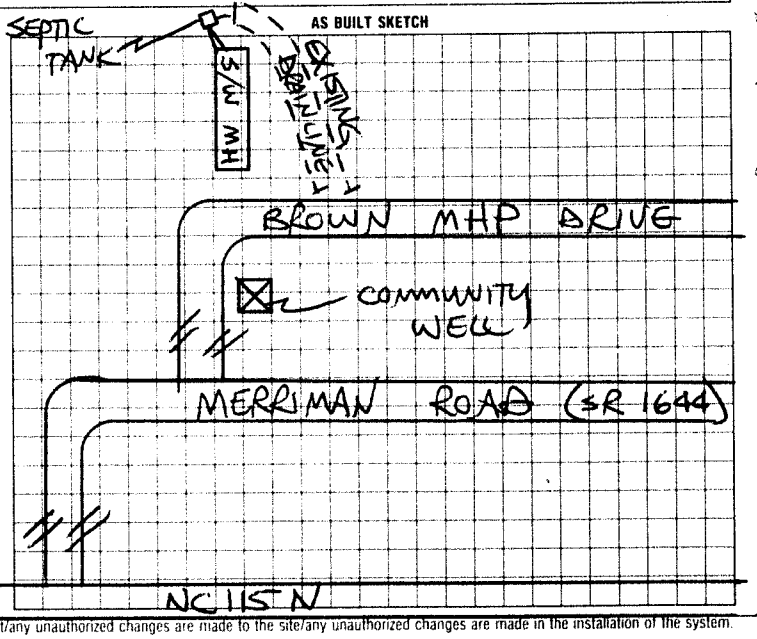

I understand that this permit can be suspended or revoked if any false information is supplied toward securing the permit/any unauthorized changes are made to the site/any unauthorized changes are made in the installation of the system. Improvement Permit is valid for 60 months from date of issuance.

Signed:

Improvement Permit by: date

Existing System Inspection by: STEVE HEDRICK date 8/4/93

Installed by:

Certificate of Completion by date

Operation Permit by date

HEALTH DEPT. COPY: WHITE INSPECTION COPY (FINAL): GREEN OWNER COPY (FINAL): YELLOW INSPECTION COPY (INITIAL): PINK OWNER COPY (INITIAL): GOLD