not on Terminal

IREDELL COUNTY HEALTH DEPARTMENT

STATESVILLE 704-878-5305 MOORESVILLE 704-664-5281

IMPROVEMENT PERMIT / CERTIFICATE OF COMPLETION / OPERATION PERMIT / EXISTING SYSTEM INSPECTION

PROPERTY DESCRIPTION NO. 17234 // CRANDALL & O'BRIEN DATE 10/11/93 TAX MAP NO 9A-A-104

OWNER OR CONTRACTOR D.A. HARE PHONE Business 871-1536 Home

ADDRESS RT. 2 BOX 226 STVL NC 28677

LOCATION NC 115N, TL SCOTTS CREEK RD, TL MILLER FARM RD, ON (L) DIRECTLY ACROSS FROM ANTLER DR.

SUBDIVISION BLOCK / SECTION LOT LOT AREA SITE CLASS PS L.T.A.R. EXISTING

Water Supply: ✓ Individual ☐ Community ☐ Public WELL

Septic Tank: EXISTING 1000 Gallons; STB Date

Pump Tank: Gallons; PT Date

Nitrification Field: No. Fields 1 Square Feet 900 Linear Feet 300

No. Lines 3 Trench Width Trench Depth Gravel Depth

☐ New System ☐ Repair System Type: (I) II III IV V VI

System Description: CONV. GRAVITY

Repair System Description:

Maintenance Agreement Required: ☐ Yes ✓ No

✓ House/Mod. Home ☐ Mobile Home ☐ Business ☐ Other

No. Bedrooms 3 No. Bathrooms 2 No. Employees

Slab ✓ Crawl Space ☐ Basement w/plumbing ☐ Basement wo/plumbing

Garbage Disposal: ☐ Yes ✓ No


Auto. Dishwasher: ✓ Yes ☐ No

Auto. Washing Machine: ✓ Yes ☐ No


Other

Comments KEEP HOUSE MINIMUM 5' FROM SEPTIC SYSTEM

INITIAL SITE SKETCH

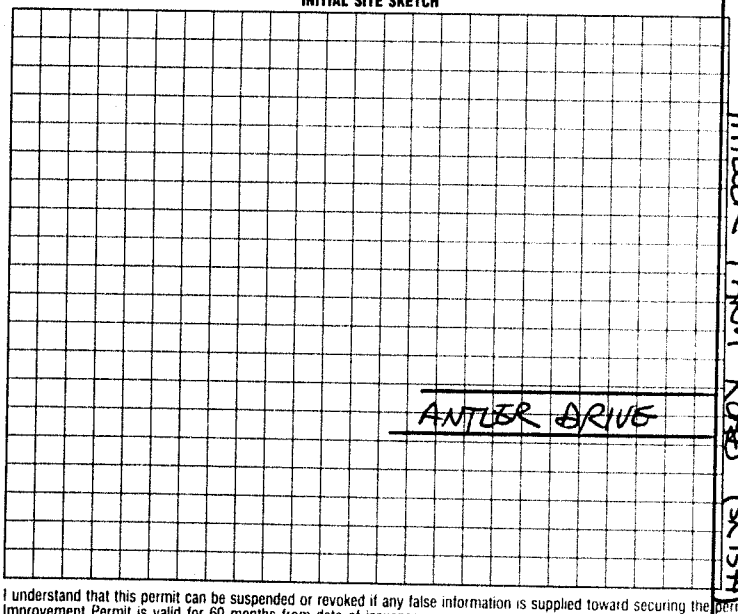

AS BUILT SKETCH

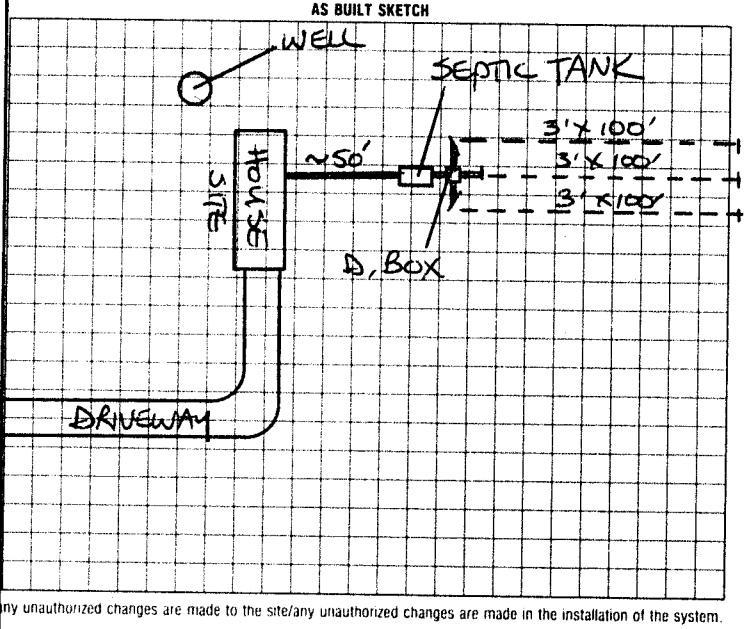

I understand that this permit can be suspended or revoked if any false information is supplied toward securing the permit/any unauthorized changes are made to the site/any unauthorized changes are made in the installation of the system. Improvement Permit is valid for 60 months from date of issuance

Signed:

Improvement Permit by: date

Existing System Inspection by: STEVE HEDRICK date 10/11/93

Installed by

Certificate of Completion by date

Operation Permit by date

HEALTH DEPT. COPY: WHITE INSPECTION COPY (FINAL) GREEN OWNER COPY (FINAL) YELLOW INSPECTION COPY (INITIAL) PINK OWNER COPY (INITIAL) GOLD