IREDELL COUNTY HEALTH DEPARTMENT

STATESVILLE 704-878-5305 MOORESVILLE 704-664-5281 55779

IMPROVEMENT PERMIT / CERTIFICATE OF COMPLETION / OPERATION PERMIT / EXISTING SYSTEM INSPECTION

PROPERTY DESCRIPTION NO. 20791 DATE 4/10/95 TAX MAP NO 9A-7-A-61

OWNER OR CONTRACTOR LISA M. JOHNSON PHONE: Business (704) 459-1523 Home (704) 459-0587 Watershed: ☐ Yes ☑ No

ADDRESS P.O. BOX 1133 CLAREMONT NC 28610

LOCATION NC 115N, TL SCOTTS CREEK, TR ENTER LN. TR DJ DRIVE, LOT 4TH L ON (R) ~ HALFWAY

SUBDIVISION WOODROSE PARK BLOCK / SECTION ____ LOT 61 LOT AREA ~103'x72' SITE CLASS PS DESIGN FLOW 360 L.T.A.R. 0.35 GPD/FT²

Septic Tank: 1000 Gallons: STB 1012 Date 9/14/95
Pump Tank: ____ Gallons: PT ____ Date ____
Pump Make: ____ Model ____ Serial No. ____
Nitrification Field: No Fields 1 Square Feet 1035 Linear Feet 345
No Lines 4-5 Trench Width 36" Max Trench Bottom Depth 18-30" Gravel Depth 12"

☑ New System ☐ Repair System Type: I (II) III, IV, V, VI
System Description: CONVENTIONAL GRAVITY
Repair System Description: CONVENTIONAL GRAVITY
Maintenance Agreement Required: ☐ Yes ☑ No


☑ House/Mod. Home ☐ Mobile Home ☐ Business ☐ Other
No. Bedrooms 3 No. Bathrooms 2 No. Employees ____
☐ Slab ☐ Crawl Space ☑ Basement w/plumbing ☐ Basement wo/plumbing

Water Supply: ☐ Individual ☐ Community ☐ Public


Comments: ① KEEP SYSTEM MINIMUM 15' FROM BASEMENT DRAIN 10' FROM PROPERTY LINE ② INSTALL LINES ON CONTOUR, NO DEEPER THAN 36", 9' APART MINIMUM AS CENTERS

Comments:

INITIAL SITE SKETCH

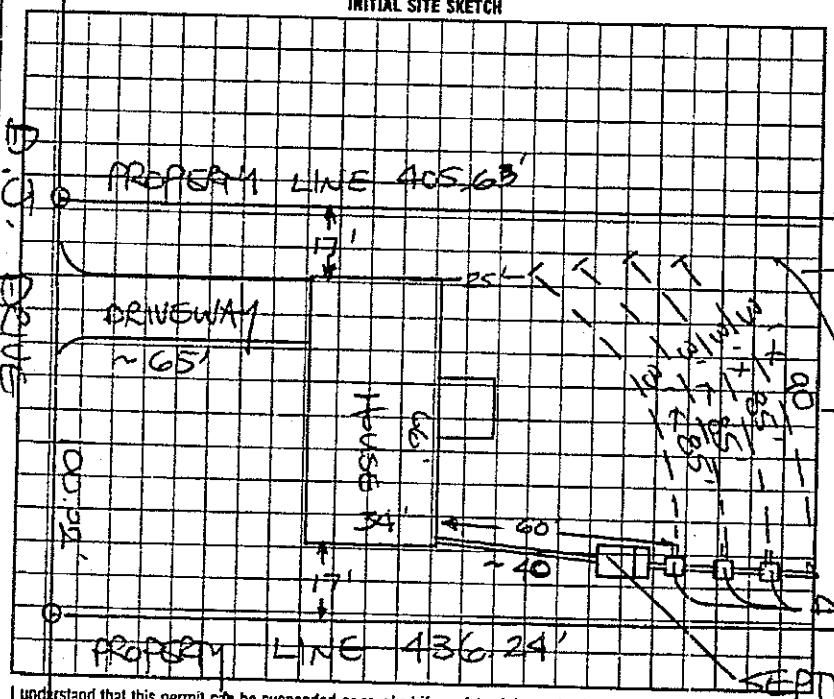

AS BUILT SKETCH

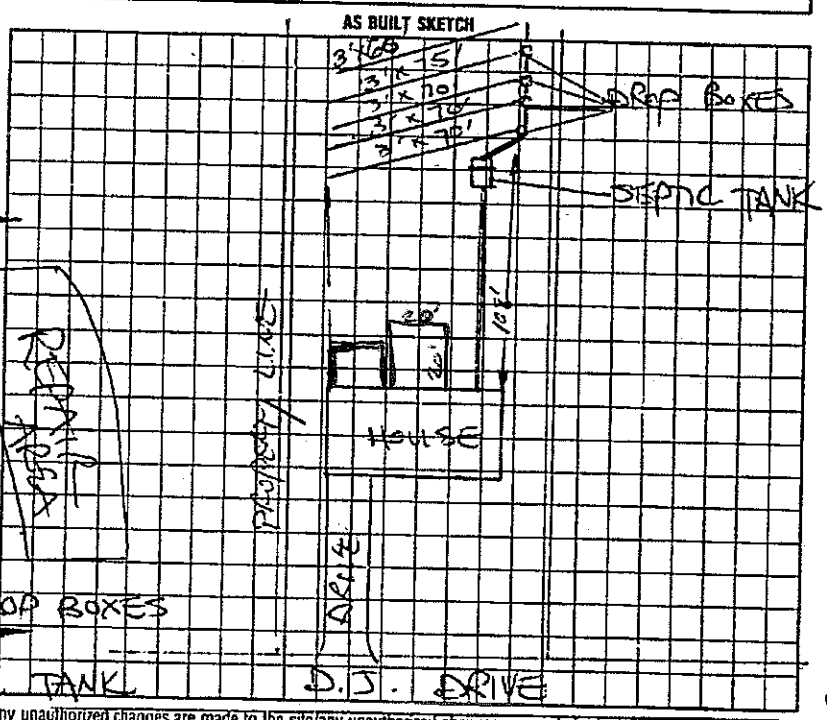

I understand that this permit can be suspended or revoked if any false information is supplied toward securing the permit/any unauthorized changes are made to the site/any unauthorized changes are made in the installation of the system. Improvement Permit is valid for 60 months from date of issuance.

Signed: Eric Johnson

Improvement Permit by: STEVE HEDRICK date 4/10/95

Installed by: ERIC JOHNSON / DAVID YOUNTZ

Certificate of Completion by: ____ date ____

Existing System Inspection by: ____ date ____

HEALTH DEPT. Location of the proposed Den Addition addition does not appear to impact the existing on-site septic system.**NOTE: ____ REHS

Date: 3-9-12

ICHD-Environmental Health Division

STEVE HEDRICK date 12-18-95

INSPECTION COPY (INITIAL): PINK OWNER COPY (INITIAL): GOLD

19822