IREDELL COUNTY HEALTH DEPARTMENT

STATESVILLE 704-878-5305 MOORESVILLE 704-664-5281

IMPROVEMENT PERMIT / AUTHORIZATION TO CONSTRUCT / OPERATION PERMIT / EXISTING SYSTEM INSPECTION

PERMIT# 97653 PIN# 4726 82 0663 DATE 2-14-00

OWNER OR CONTRACTOR Hartin + Associates PHONE: Business 663 6718 Home

ADDRESS 1002 Brawcliff Rd Mooresville N.C.

LOCATION 115N Tb Scotts Creek Tb miller Fm Tb Cross Creek 2nd lot left

SUBDIVISION Cross Creek BLOCK / SECTION LOT 11 LOT AREA .36 acres SITE CLASS PS DESIGN FLOW 360 L.T.A.R. .3

Septic Tank: 1000 Gallons; STB 1012 Date 4-1-00
Pump Tank: Gallons; PT Date
Pump Make: Model Serial No.
Nitrification Field: No Fields 1 Square Feet 936 Linear Feet 312
No Lines 5 Trench Width 36" Max Trench Bottom Depth 36"

☑ New System ☐ Repair System Type: I. II (III) IV. V. VI
System Description: Gravity 25% Red.
Repair System Description:
Maintenance Agreement Required: ☐ Yes ☑ No
Gravel Depth N/A ☐ Slab ☑ Crawl Space ☐ Basement w/plumbing ☐ Basement wo/plumbing


☑ House/Mod. Home No. Bedrooms 3
☐ Mobile Home No. Bathrooms 2
☐ Business No. Employees
☐ Other

Water Supply: ☐ Individual ☑ Public ☐ Community

Comments/Conditions:

Comments/Conditions: SEPTIC TANK W/ RISERS INSTALLED USING "POLYLOK" FILTER

INITIAL SITE SKETCH

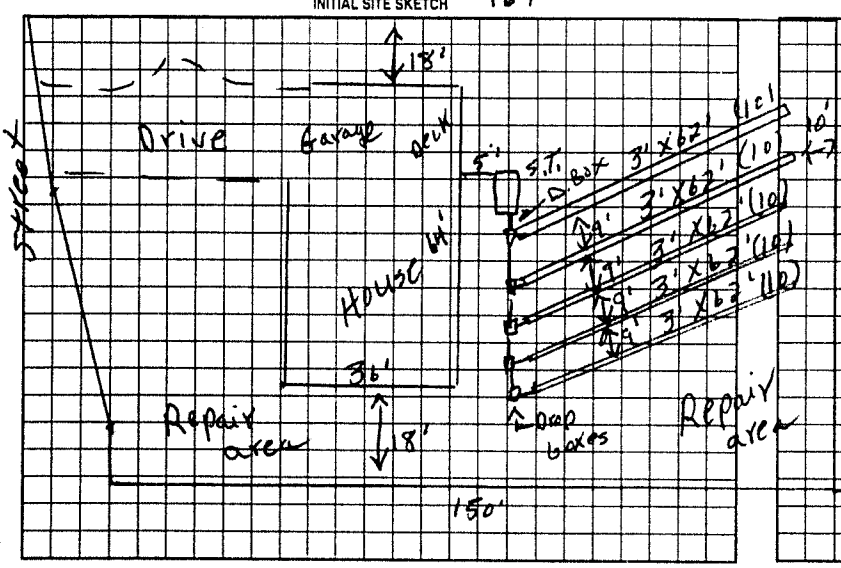

AS BUILT SKETCH

SYSTEM INSTALLED ACCORDING TO INITIAL SITE SKETCH

Permit can be suspended or revoked if any false information is supplied toward securing the permit/any unauthorized changes are made to the site/any unauthorized changes are made in the installation of the system. Improvement Permit with plat valid without expiration. Improvement Permit with site plan valid for sixty months. Authorization to Construct is valid for a period equal to that of Improvement Permit – not to exceed sixty months.

Signed: Steven W. Hartin date 2-17-00 Installed by: DAVID YOUNTZ

Improvement Permit by: F. C. Moore date 2-14-00 Operation Permit by: STEVE HEDRICK date 5-24-00

Authorization to Construct by: F. C. Moore date 2-14-00 Existing System Inspection by: date

HEALTH DEPT COPY WHITE OWNER COPY (FINAL) YELLOW OWNER COPY (INITIAL) PINK