IREDELL COUNTY HEALTH DEPARTMENT

STATESVILLE 704-878-5305 MOORESVILLE 704-664-5281

IMPROVEMENT PERMIT / AUTHORIZATION TO CONSTRUCT / OPERATION PERMIT / EXISTING SYSTEM INSPECTION

PERMIT# 073466 PIN# 4726 82 4301 (PT) DATE 5-27-98

OWNER OR CONTRACTOR SAMUEL SCOTT PHONE: Business Home 873-1391

ADDRESS 2278 S. CHIPLEY FORD, STATESVILLE, NC 28625

LOCATION NC 115 NORTH, TL SCOTTS CREEK ROAD, 2ND LOT ON LEFT BEFORE MILLER FARM ROAD

SUBDIVISION CROSS CREEK BLOCK / SECTION I LOT 8 LOT AREA 16,714.2 SITE CLASS PS DESIGN FLOW 360 L.T.A.R. .033 GAD/FT²

Septic Tank: 1000 Gallons; STB 1012 Date 6-15-99
Pump Tank: _____ Gallons; PT _____ Date _____
Pump Make: _____ Model _____ Serial No. _____
Nitrification Field: No Fields 1 Square Feet Eq. to 1080 Linear Feet 270+
No Lines FIVE Trench Width 36" Max Trench Bottom Depth 36" Gravel Depth SAND 6"

☑ New System ☐ Repair System Type: I, II, (III), IV, V, VI
System Description: CHAMBERED GRAVITY
Repair System Description: CHAMBERED GRAV. PUMP
Maintenance Agreement Required: ☐ Yes ☑ No


☑ House/Mod. Home No. Bedrooms 3
☐ Mobile Home No. Bathrooms 2
☐ Business No. Employees ____
☐ Other ____
☐ Slab ☑ Crawl Space ☐ Basement w/plumbing ☐ Basement wo/plumbing

Water Supply: ☐ Individual ☑ Public ☐ Community

Comments:/Conditions: INSTALL FORTY-FIVE (45) CHAMBERS IN FIVE LINES AS SHOWN BELOW

Comments:/Conditions: SEPTIC TANK WITH RISERS INSTALLED USING "POLYLOK" FILTERS

INITIAL SITE SKETCH SCALE: 1" = 30'

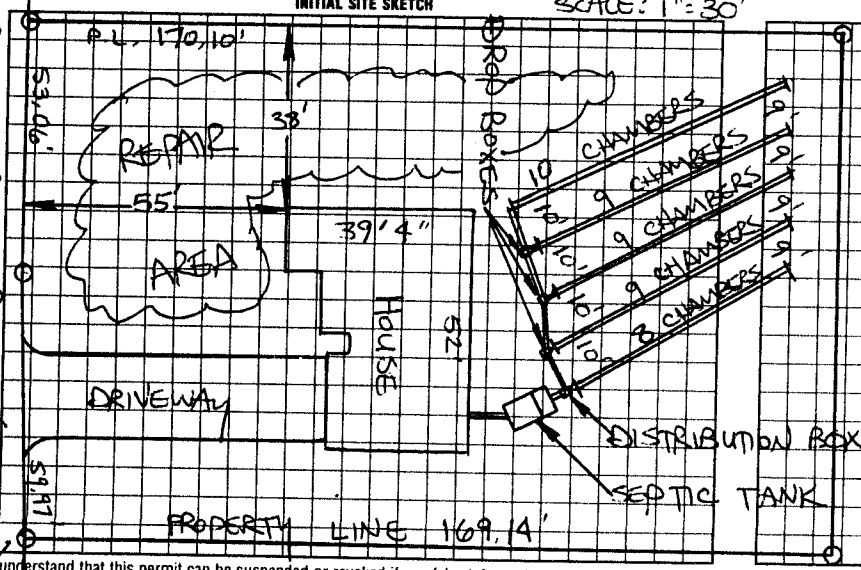

AS BUILT SKETCH

SYSTEM INSTALLED ACCORDING TO INITAL SITE SKETCH

SCOTTS CREEK ROAD (SR 1551)

I understand that this permit can be suspended or revoked if any false information is supplied toward securing the permit/any unauthorized changes are made to the site/any unauthorized changes are made in the installation of the system. Improvement Permit with plat valid without expiration. Improvement Permit with site plan valid for sixty months. Authorization to Construct is valid for a period equal to that of Improvement Permit – not to exceed sixty months.

Signed: Samuel A Scott date 5-29-98

Improvement Permit by: STEVE HEDRICK date 5-27-98

Authorization to Construct by: STEVE HEDRICK date 5-27-98

Installed by: DAVID YOUNTZ

Operation Permit by: STEVE HEDRICK date 8-18-99

Existing System Inspection by: _____ date _____

HEALTH DEPT. COPY: WHITE INSPECTION COPY (FINAL): GREEN OWNER COPY (FINAL): YELLOW INSPECTION COPY (INITIAL): PINK OWNER COPY (INITIAL): GOLD