IREDELL COUNTY HEALTH DEPARTMENT

STATESVILLE 704-878-5305 MOORESVILLE 704-664-5281

IMPROVEMENT PERMIT / AUTHORIZATION TO CONSTRUCT / OPERATION PERMIT / EXISTING SYSTEM INSPECTION

PERMIT# 81719 PIN# 4726823288 DATE July 28, 99

OWNER OR CONTRACTOR Samuel Scott PHONE Business 873 1391 Home

ADDRESS 2278 S Chipley Ford Rd Statesville, NC

LOCATION 115 N @ Scotts Creek @ Miller Farm @ Cross Creek on Right

SUBDIVISION Cross Creek BLOCK / SECTION LOT 21 LOT AREA 17,544 sqft SITE CLASS PS DESIGN FLOW 360 L.T.A.R. .3

Septic Tank: 1000 Gallons: STB 1012 Date 8-29-99
Pump Tank: Gallons: PT Date
Pump Make: Model Serial No
Nitrification Field: No Fields 1 Square Feet 1200 Linear Feet 300
No Lines 5 Trench Width 36" Max Trench Bottom Depth 36"

☒ New System ☐ Repair System Type I II III IV V VI
System Description 25% Reduction GRAVITY
Repair System Description Pump 25-50% Reduction
Maintenance Agreement Required ☐ Yes ☒ No
Gravel Depth N/A ☐ Slab ☒ Crawl Space ☐ Basement w/plumbing ☐ Basement wo/plumbing


☒ House/Mod Home ☐ Mobile Home ☐ Business ☐ Other
No. Bedrooms 3 No. Bathrooms 2 No. Employees

Water Supply: ☐ Individual ☒ Public ☐ Community

Comments/Conditions Keep All Setbacks From property & House
50 chambers or 30 HDS sections

Comments Conditions SYSTEM SEPTIC TANK WITH RISERS INSTALLED USING "POLYLOK" FILTER

INITIAL SITE SKETCH

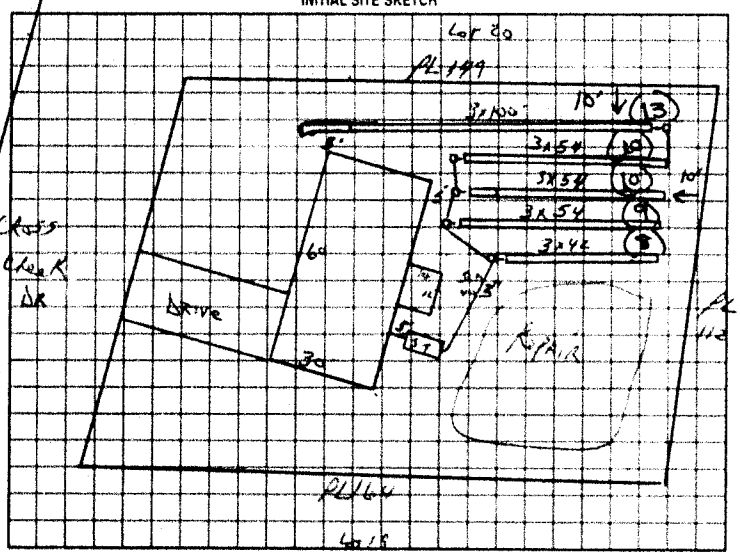

AS BUILT SKETCH

SYSTEM INSTALLED ACCORDING TO INITIAL SITE SKETCH (50 CHAMBERS)

Permit can be suspended or revoked if any false information is supplied toward securing the permit; any unauthorized changes are made to the site; any unauthorized changes are made in the installation of the system. Improvement Permit with plat valid without expiration. Improvement Permit with site plan valid for sixty months. Authorization to Construct is valid for a period equal to that of Improvement Permit - not to exceed sixty months

Signed: Samuel A Scott date 7-29-99

Improvement Permit by: J C Potter date 7-29-99

Authorization to Construct by: J C Potter date 7-29-99

Installed by DAVID YOUNTZ

Operation Permit by STEVE HENDRICK date 11-12-99

Existing System Inspection by date

HEALTH DEPT COPY: WHITE OWNER COPY (FINAL): YELLOW OWNER COPY (INITIAL): PINK