IREDELL COUNTY HEALTH DEPARTMENT

STATESVILLE 704-878-5305 CI MOORESVILLE 704-664-5281

IMPROVEMENT PERMIT / AUTHORIZATION TO CONSTRUCT / OPERATION PERMIT / EXISTING SYSTEM INSPECTION

PERMIT# 114708 PIN# 4726-82-2073 DATE 8-12-03

OWNER OR CONTRACTOR SAMUEL G. SCOTT CONTRACTING CO., INC. PHONE: Business 704-902-3230 Home 704-873-1391

ADDRESS 2278 S. CHIPLEY FORD ROAD STATESVILLE, NC 28625

LOCATION NC 115 NORTH, TL SCOTTS CREEK RD, TL MILLER FARM RD, TL GLEN CROSS DRIVE, LOT ON RIGHT AT END

SUBDIVISION CROSS CREEK BLOCK / SECTION II LOT 32 LOT AREA 15,702.5 FT² SITE CLASS. PS DESIGN FLOW 360 L.T.A.R. 0.30 GPD/FT²

Septic Tank: 1000 Gallons; STB 10/2 Date 8-2-03

Pump Tank: _____ Gallons; PT _____ Date _____

Pump Make: _____ Model _____ Serial No. _____

Nitrification Field: No Fields 1 Square Feet 1200 Linear Feet 300

No Lines SIX Trench Width 36" Max Trench Bottom Depth 36" Gravel Depth N/A

☑ New System ☐ Repair System Type: I, II, III, IV, V, VI

System Description: 25% REDUCTION, GRAVITY

Repair System Description: 50% REDUCTION, LOW PRESSURE

Maintenance Agreement Required: ☐ Yes ☑ No

☑ House/Mod. Home ☐ Mobile Home ☐ Business ☐ Other

No. Bedrooms 3 No. Bathrooms 2 No. Employees ____

☐ Slab ☑ Crawl Space ☐ Basement w/plumbing ☐ Basement wo/plumbing


Water Supply: ☐ Individual ☑ Public ☐ Community

Comments:/Conditions: USE ONE FLOW DIVIDER TEE TO ACHIEVE EQUAL DISTRIBUTION INTO TWO SETS OF DROP BOXES AS SHOWN. INSTALL 25% REDUCTION SYSTEM ON CONTOUR.

Comments:/Conditions: -ST marker + Tuff Tite marker

-48 Infiltrators Installed.

INITIAL SITE SKETCH

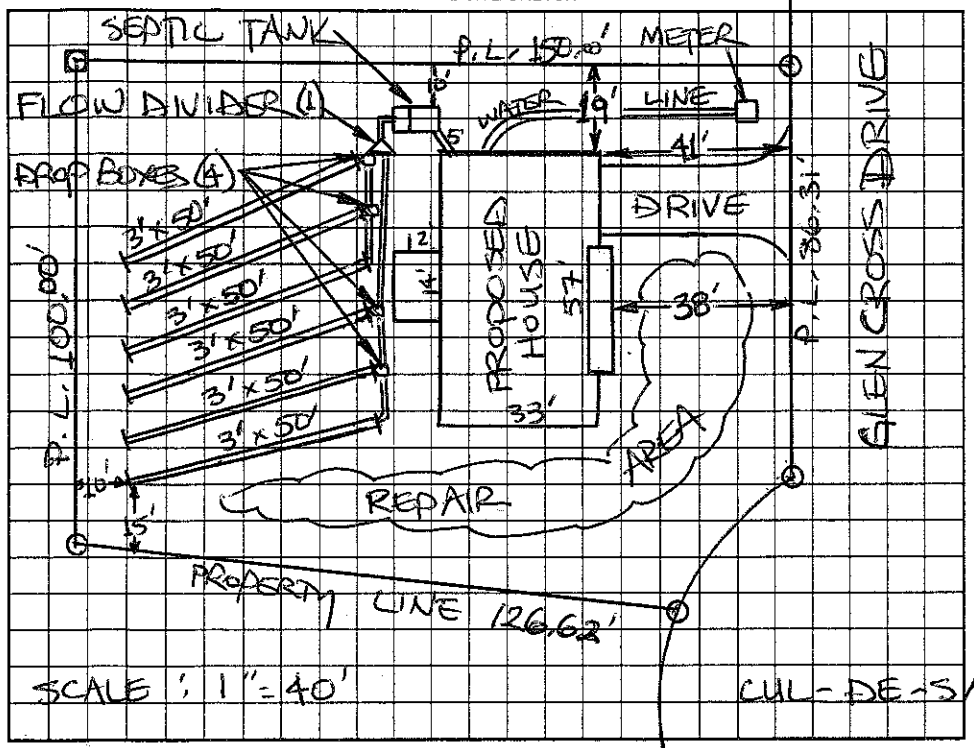

AS BUILT SKETCH

Installed As Shown per Initial Site Sketch

Permit can be suspended or revoked if any false information is supplied toward securing the permit/any unauthorized changes are made to the site/any unauthorized changes are made in the installation of the system. Improvement Permit with plat valid without expiration. Improvement Permit with site plan valid for sixty months. Authorization to Construct is valid for a period equal to that of Improvement Permit – not to exceed sixty months.

Signed: Samuel G Scott date 8-21-03 Installed by: David Yountz

Improvement Permit by: STEVE HEDRICK date 8-12-03 Operation Permit by: William O John date 1/20/04

Authorization to Construct by: STEVE HEDRICK date 8-12-03 Existing System Inspection by: _____ date _____

HEALTH DEPT. COPY: WHITE OWNER COPY (FINAL): YELLOW OWNER COPY (INITIAL): PINK