IREDELL COUNTY HEALTH DEPARTMENT

STATESVILLE 704-878-5305 MOORESVILLE 704-664-5281

IMPROVEMENT PERMIT / AUTHORIZATION TO CONSTRUCT / OPERATION PERMIT / EXISTING SYSTEM INSPECTION

PERMIT# 81720 PIN# 4726823288 DATE July 26, 99

OWNER OR CONTRACTOR Samuel Scott PHONE: Business 873 1591 Home

ADDRESS 2278 S Chipley Ford Rd. Statesville, NC

LOCATION 115 N ① Scotts Creek ② Miller Farm ③ Cross Ck RD ④

SUBDIVISION Cross Creek BLOCK / SECTION II LOT 13 LOT AREA 13,000 Sq Ft SITE CLASS. PS DESIGN FLOW 360 L.T.A.R. .3

Septic Tank: 1000 Gallons; STB 1012 Date 11-29-99
Pump Tank: Gallons; PT Date
Pump Make: Model Serial No.
Nitrification Field: No Fields 1 Square Feet 1200 Linear Feet 300
No Lines 6 Trench Width 36" Max Trench Bottom Depth 36"

☒ New System ☐ Repair System Type: I II III IV V VI
System Description: 25% Reduction GRAVITY
Repair System Description: 50% Reduction GRAVITY/Pump
Maintenance Agreement Required: ☐ Yes ☒ No
Gravel Depth N/A ☐ Slab ☒ Crawl Space ☐ Basement w/plumbing ☐ Basement wo/plumbing

☒ House/Mod. Home No. Bedrooms 3
☐ Mobile Home No. Bathrooms 2
☐ Business No. Employees
☐ Other


Water Supply: ☐ Individual ☒ Public ☐ Community

Comments/Conditions: INSTALL on CONTOUR, SET TANK AS FAR up hill AS possible TO begin Lines AS FAR up AS possible 5-6 Drop Boxes
5 Chambers OR 30 HDS sections


Comments/Conditions SEPTIC TANK W/ RISERS INSTALLED USING "POLYLOK" FILTER

INITIAL SITE SKETCH

1"=40" scale

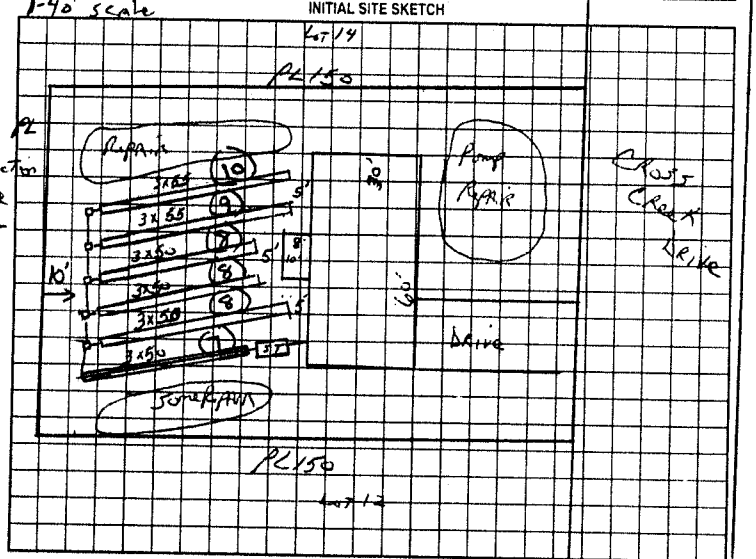

AS BUILT SKETCH

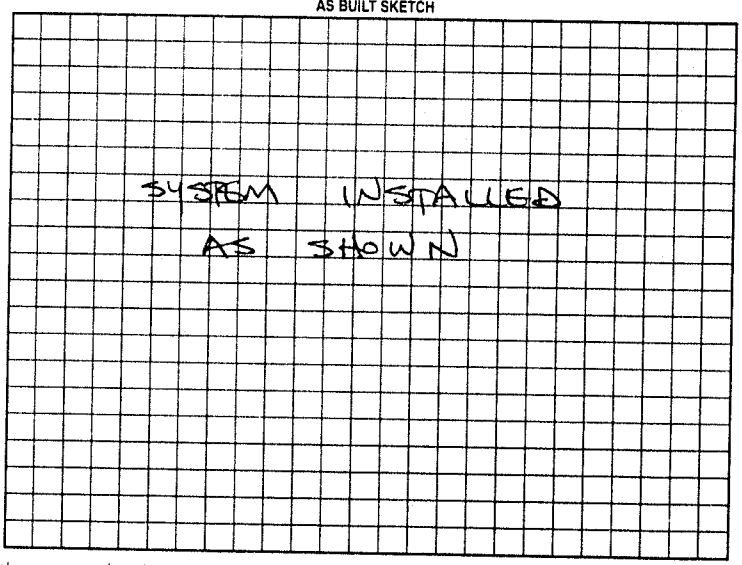

Permit can be suspended or revoked if any false information is supplied toward securing the permit/any unauthorized changes are made to the site/any unauthorized changes are made in the installation of the system. Improvement Permit with soil valid without expiration. Improvement Permit with site plan valid for sixty months. Authorization to Construct is valid for a period equal to that of Improvement Permit – not to exceed sixty months.

Signed: Samuel Scott date 7-29-99

Improvement Permit by: Joe Potter date 7-27-99

Authorization to Construct by: Joe Potter date 7-27-99

Installed by: DAVID YOUNTZ

Operation Permit by: STEVE HEDRICK date 3-28-00

Existing System Inspection by: date

HEALTH DEPT. COPY: WHITE OWNER COPY (FINAL): YELLOW OWNER COPY (INITIAL): PINK