IREDELL COUNTY HEALTH DEPARTMENT

STATESVILLE 704-878-5305 CI MOORESVILLE 704-664-5281

IMPROVEMENT PERMIT / AUTHORIZATION TO CONSTRUCT / OPERATION PERMIT / EXISTING SYSTEM INSPECTION

PERMIT# 095366 PIN# 4726 82 [redacted] 3531 DATE 6/20/01

OWNER OR CONTRACTOR Samuel G. Scott PHONE: Business (704) 873-1391 Home

ADDRESS 2278 S. Chipley Ford Rd. Statesville NC 28625

LOCATION I-15 N, @ Scotts Creek Rd @ Miller Farm Rd, @ Cross Creek Drive on Left

SUBDIVISION Cross Creek BLOCK / SECTION II LOT [redacted] LOT AREA .34 SITE CLASS. PS DESIGN FLOW 360 L.T.A.R. .3

Septic Tank: 1,000 Gallons; STB 1012 Date 6-10-03
Pump Tank: Gallons; PT Date
Pump Make: Model Serial No.
Nitrification Field: No Fields 1 Square Feet equivalent to 1200 Linear Feet 300'
No Lines 6 (5) Trench Width 36" Max Trench Bottom Depth 36" Gravel Depth —

☒ New System ☐ Repair System Type: I, II, III, IV, V, VI
System Description: Gravity, 25% Reduction
Repair System Description: Pump, 50% Reduction
Maintenance Agreement Required: ☐ Yes ☒ No


☒ House/Mod. Home No. Bedrooms 3
☐ Mobile Home No. Bathrooms 2
☐ Business No. Employees
☐ Other
☐ Slab ☒ Crawl Space ☐ Basement w/plumbing ☐ Basement wo/plumbing

Water Supply: ☐ Individual ☒ Public ☐ Community


Comments:/Conditions: ① Install 25% Reduction System - 50 chambers or 30-10ft HOES Sections ② Install on Contour ③ Do not Install when wet.

Comments:/Conditions: Tuff Tite Filter + ST Marker - 48 Infiltrator Chambers Installed

INITIAL SITE SKETCH 1" = 40 ft

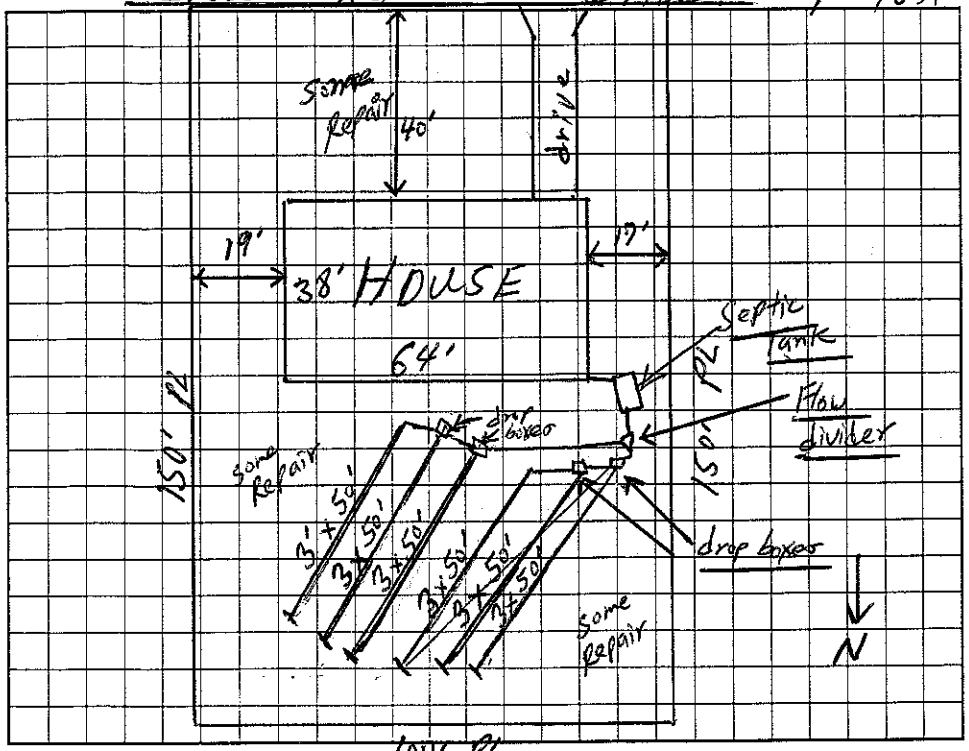

AS BUILT SKETCH

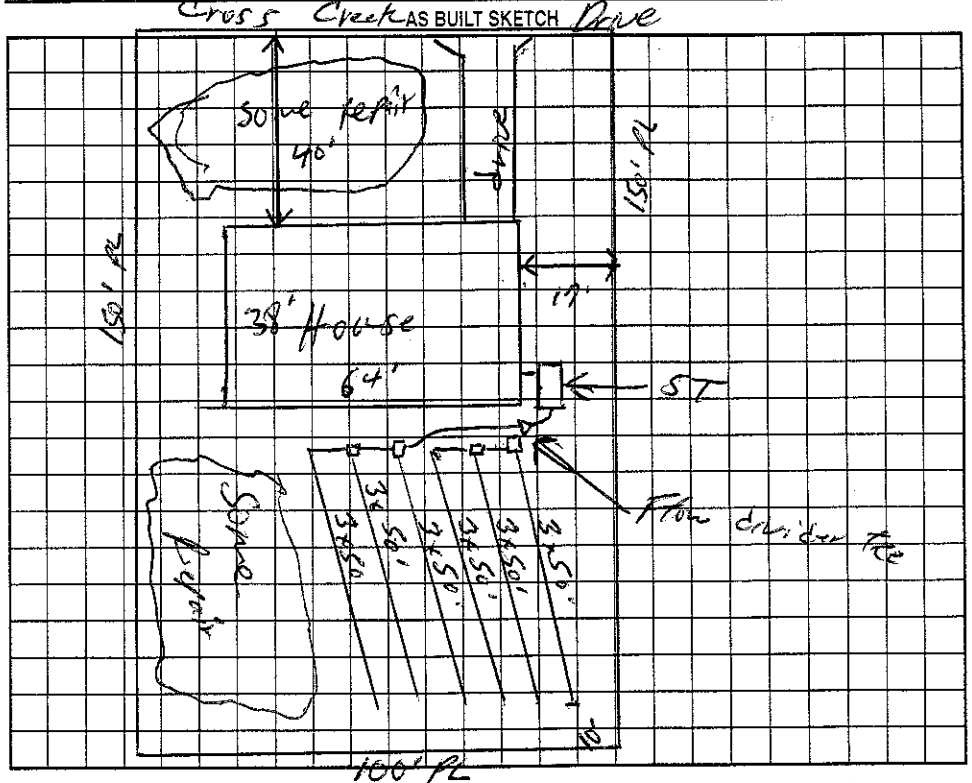

Permit can be suspended or revoked if any false information is supplied toward securing the permit/any unauthorized changes are made to the site/any unauthorized changes are made in the installation of the system. Improvement Permit with plat valid without expiration. Improvement Permit with site plan valid for sixty months. Authorization to Construct is valid for a period equal to that of Improvement Permit – not to exceed sixty months.

Signed: [signature] date 6-25-01 Installed by: David Younts

Improvement Permit by: William O. Johnson RSI date 6/20/01 Operation Permit by: William O. Johnson date 11/21/03

Authorization to Construct by: William O. Johnson RSI date 6/20/01 Existing System Inspection by: date

HEALTH DEPT. COPY: WHITE OWNER COPY (FINAL): YELLOW OWNER COPY (INITIAL): PINK