IREDELL COUNTY HEALTH DEPARTMENT

STATESVILLE 704-878-5305 MOORESVILLE 704-664-5281

IMPROVEMENT PERMIT / AUTHORIZATION TO CONSTRUCT / OPERATION PERMIT / EXISTING SYSTEM INSPECTION

PERMIT# 73266 PIN# 4726824301 DATE 5-4-98

OWNER OR CONTRACTOR Harkin + Associates PHONE: Business 662-0242 Home

ADDRESS 1002 Briarcliff Road Mooresville

LOCATION 115 N TL Scotts Creek Rd before Miller Farm Rd

SUBDIVISION Cross Creek BLOCK / SECTION LOT 5 LOT AREA 18416 SITE CLASS. PS DESIGN FLOW 360 L.T.A.R. 1.3

Septic Tank: 1000 Gallons; STB 1012 Date 5-29-98

Pump Tank: Gallons; PT Date

Pump Make: Model Serial No.

Nitrification Field: No Fields 1 Square Feet 900 Linear Feet 300

No Lines 6 Trench Width 36" Max Trench Bottom Depth 36" Gravel Depth N/A

☑ New System ☐ Repair System Type: I, II, III, IV, V, VI

System Description: Gravity/Chambers

Repair System Description: Pump To Chambers

Maintenance Agreement Required: ☐ Yes ☑ No HDS

☑ House/Mod. Home No. Bedrooms 3

☐ Mobile Home No. Bathrooms 2

☐ Business No. Employees

☐ Other


☐ Slab ☑ Crawl Space ☐ Basement w/plumbing ☐ Basement wo/plumbing

Water Supply: ☐ Individual ☑ Public ☐ Community


Comments:/Conditions:

Comments:/Conditions:

INITIAL SITE SKETCH

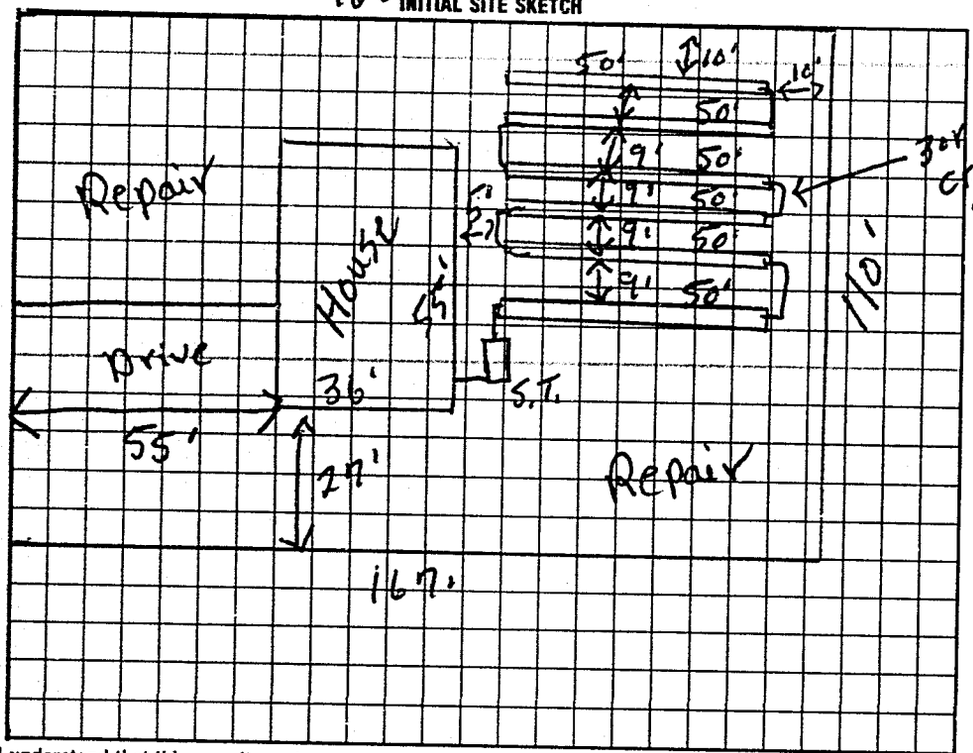

AS BUILT SKETCH

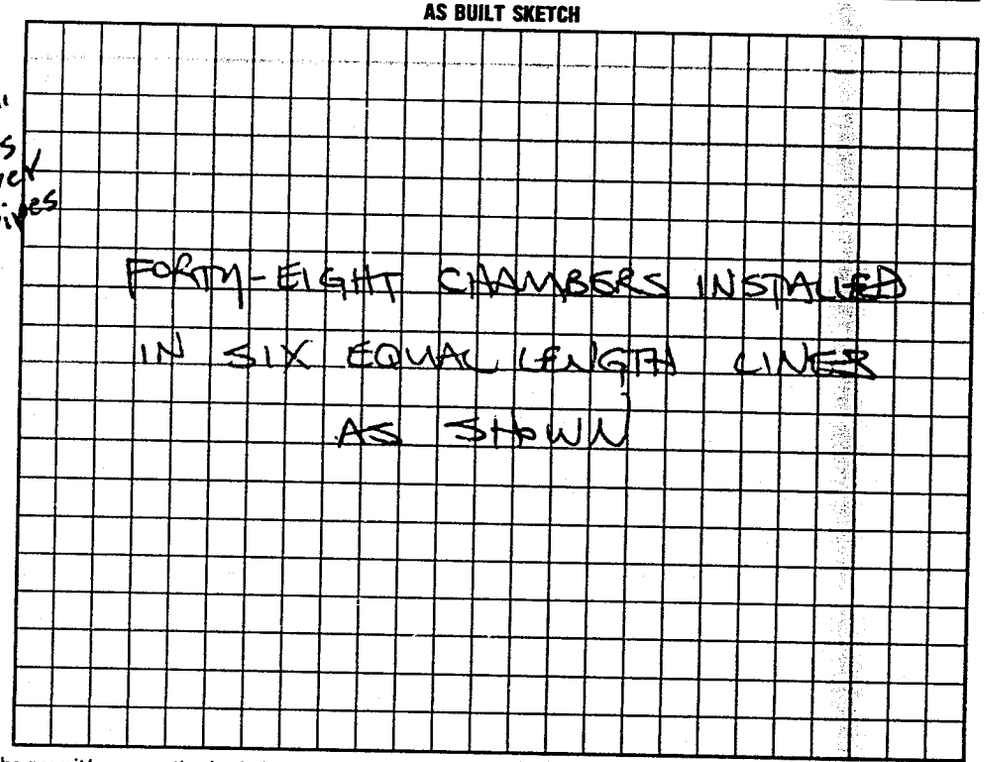

I understand that this permit can be suspended or revoked if any false information is supplied toward securing the permit/any unauthorized changes are made to the site/any unauthorized changes are made in the installation of the system. Improvement Permit with plat valid without expiration. Improvement Permit with site plan valid for sixty months. Authorization to Construct is valid for a period equal to that of Improvement Permit – not to exceed sixty months.

Signed: Steven W Harkin date 5-7-98

Improvement Permit by: L.C. Moore date 5-4-98

Authorization to Construct by: L.C. Moore date 5-4-98

Installed by: DAVID YOUNTZ

Operation Permit by: STEVE HERRICK date 8-4-98

Existing System Inspection by: date

HEALTH DEPT. COPY-WHITE INSPECTION COPY (FINAL) GREEN OWNER COPY (FINAL) YELLOW INSPECTION COPY (INITIAL) PINK OWNER COPY (INITIAL) GOLD