IREDELL COUNTY HEALTH DEPARTMENT

STATESVILLE 704-878-5305 MOORESVILLE 704-664-5201

IMPROVEMENT PERMIT / AUTHORIZATION TO CONSTRUCT / OPERATION PERMIT / EXISTING SYSTEM INSPECTION

DATE 8/15/01

PERMIT# 101721 PIN# 4726-82-3070 PHONE: Business (704) 902-3230 Home (704) 873-1391

OWNER OR CONTRACTOR Samuel C. Scott

ADDRESS 2278

LOCATION 115 N @ Scotts Creek @ Mills Farm Rd @ Glen Cross Drive, 1st End on Right

SUBDIVISION Crest Creek BLOCK / SECTION II LOT 31 LOT AREA 58,226 sqft SITE CLASS V5 DESIGN FLOW 360 L.T.A.R. .30

Septic Tank: 1,000 Gallons; STB 101 2 Date 8-10-01

Pump Tank: ____ Gallons; PT ____ Date ____

Pump Make: ____ Model ____ Serial No. ____

Nitrification Field: No Fields 1 Square Feet +/- 1200 Linear Feet 300'

No Lines 5 Trench Width 36" Max Trench Bottom Depth 26" Gravel Depth ____

☒ New System ☐ Repair System Type: I, II, (III), IV, V, VI

System Description: Gravity 25% Reduction

Repair System Description: Gravity 25% Reduction

Maintenance Agreement Required: ☐ Yes ☐ No

☒ House/Mod. Home ☐ Mobile Home ☐ Business ☐ Other

No. Bedrooms 3 No. Bathrooms 2 No. Employees ____

Water Supply: ☐ Individual ☒ Public ☐ Community


☐ Slab ☒ Crawl Space ☐ Basement w/plumbing ☐ Basement wo/plumbing

Comments:/Conditions:


Comments:/Conditions: (1) Lot #30+31 to be Combined (2) Install Riser on Septic Tank

- Install 4" Effluent Filter
- Septic Tank Risers Installed

INITIAL SITE SKETCH

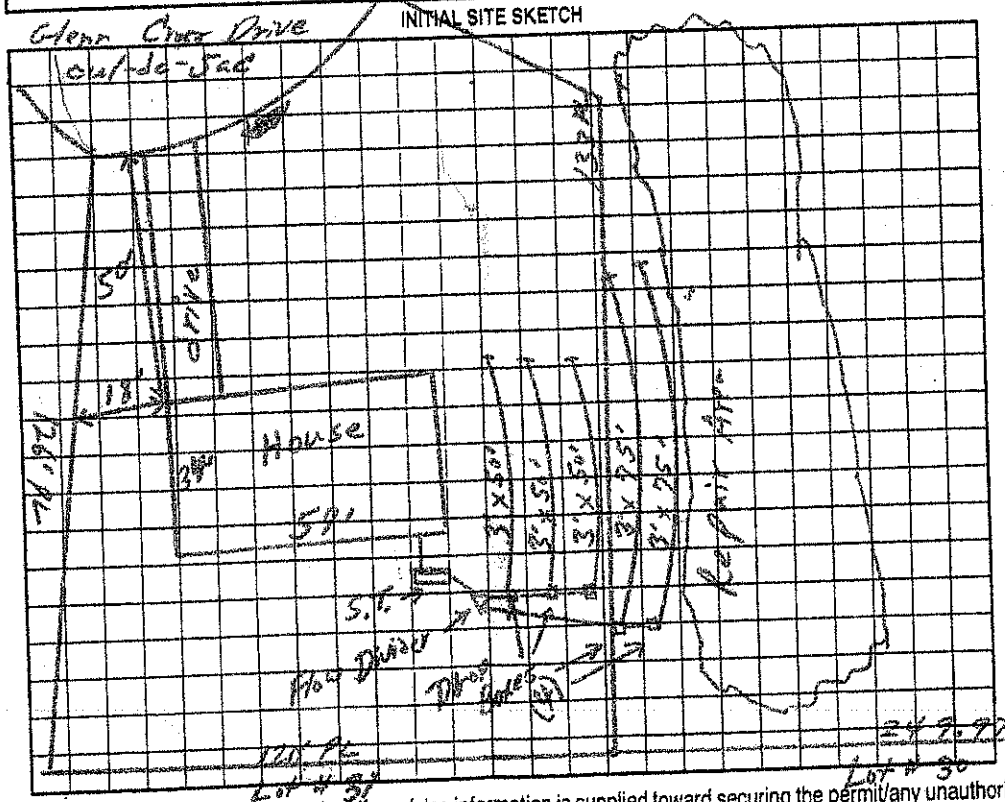

AS BUILT SKETCH

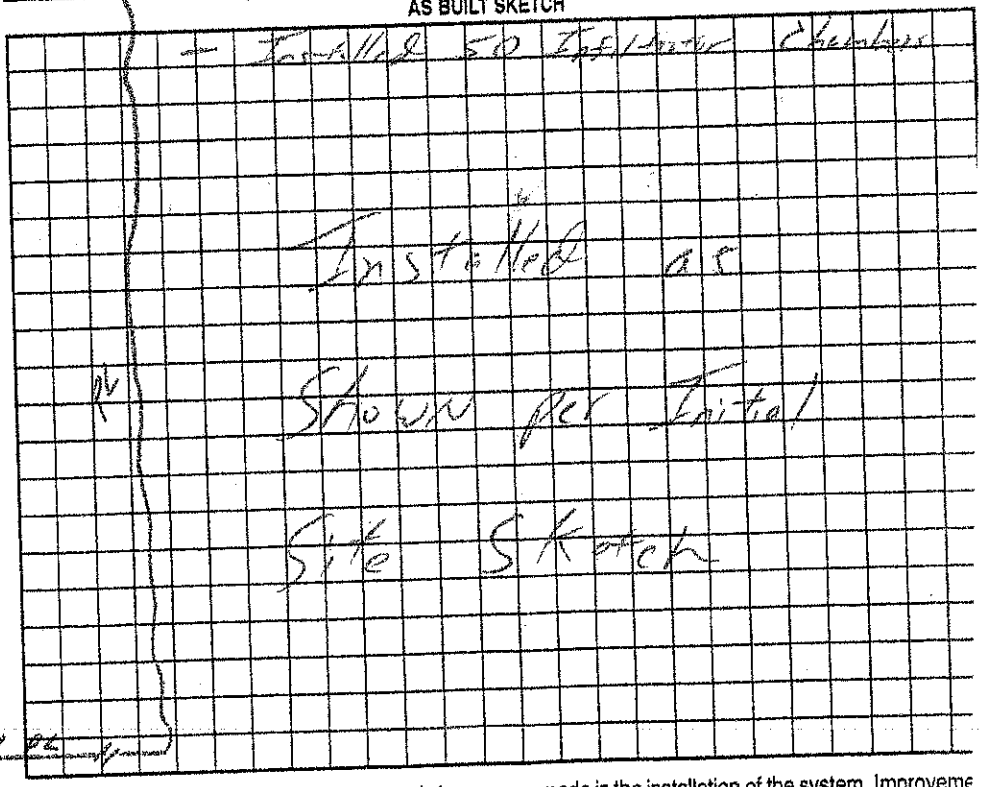

Permit can be suspended or revoked if any false information is supplied toward securing the permit/any unauthorized changes are made to the site/any unauthorized changes are made in the installation of the system. Improvement Permit with plat valid without expiration. Improvement Permit with site plan valid for sixty months. Authorization to Construct is valid for a period equal to that of Improvement Permit – not to exceed sixty months.

Signed: Samuel C. Scott date 8/15/01 Installed by: David Yount

Improvement Permit by: William O. Johnson date 8/15/01 Operation Permit by: William O. Johnson date 10/15/01

Authorization to Construct by: William O. Johnson date 8/15/01 Existing System Inspection by: ____ date ____

OWNER COPY (FINAL): YELLOW OWNER COPY (INITIAL): PINK