IREDELL COUNTY HEALTH DEPARTMENT

STATESVILLE 704-878-5305 MOORESVILLE 704-664-5281

IMPROVEMENT PERMIT / AUTHORIZATION TO CONSTRUCT / OPERATION PERMIT / EXISTING SYSTEM INSPECTION

PERMIT# 074957 PIN# 4726 82 5569 DATE 8-12-98

OWNER OR CONTRACTOR HARDIN AND ASSOCIATES PHONE: Business Home

ADDRESS 1002 BRIAR CLIFF ROAD, MOORESVILLE, NC 28115-2711

LOCATION NC 115 N, TL SCOTTS CREEK RD, 3RD LOT ON LEFT PAST BOWMAN ROAD

SUBDIVISION CROSS CREEK BLOCK / SECTION I LOT 3 LOT AREA 18,265.3 SF SITE CLASS PS DESIGN FLOW 360 L.T.A.R. 0.30 GPD/FT²

Septic Tank: 1000 Gallons; STB 1012 Date 2-20-99

Pump Tank: Gallons; PT Date

Pump Make: Model Serial No.

Nitrification Field: No Fields 1 Square Feet 60 TO 1200 Linear Feet 300

No Lines SIX Trench Width 36" Max Trench Bottom Depth 30

☑ New System ☐ Repair System Type: I, II, (III), IV, V, VI

System Description: 25% REDUCTION-GRAVITY

Repair System Description: PPBPS, LOW-PRESSURE

Maintenance Agreement Required: ☐ Yes ☑ No

Gravel Depth SAND 6"

☑ House/Mod. Home No. Bedrooms 3

☐ Mobile Home No. Bathrooms 2

☐ Business No. Employees

☐ Other


☐ Slab ☑ Crawl Space ☐ Basement w/plumbing ☐ Basement wo/plumbing

Water Supply: ☐ Individual ☑ Public ☐ Community


Comments:/Conditions: ① CONSTRUCT SUBSURFACE INTERCEPT DRAINAGE DITCH AT LOCATION SHOWN BEGINNING 12" DEEP OUT TO DAYLIGHT ② INSTALL 25% REDUCTION SYSTEM, NO DEEPER THAN 30".

Comments:/Conditions:

INITIAL SITE SKETCH SCALE: 1" = 30'

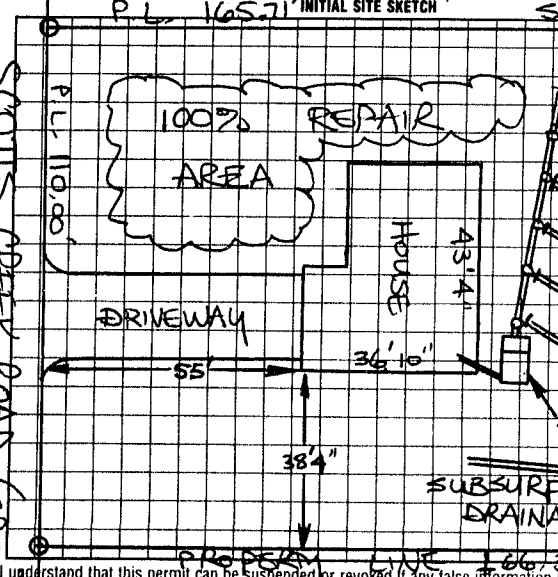

AS BUILT SKETCH

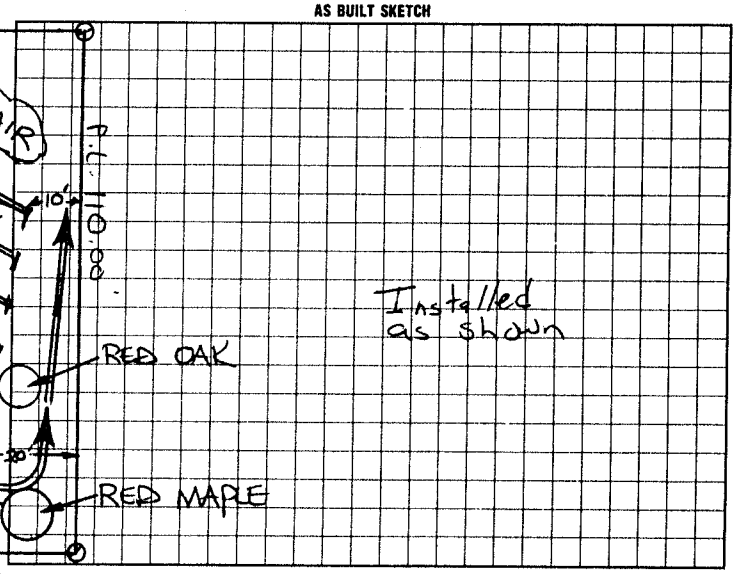

I understand that this permit can be suspended or revoked if any false information is supplied toward securing the permit/any unauthorized changes are made to the site/any unauthorized changes are made in the installation of the system. Improvement Permit with plat valid without expiration. Improvement Permit with site plan valid for sixty months. Authorization to Construct is valid for a period equal to that of Improvement Permit – not to exceed sixty months.

Signed: X Steve Hardin date 8-12-98

Improvement Permit by: STEVE HEDRICK date 8-12-98

Authorization to Construct by: STEVE HEDRICK date 8-12-98

Installed by: David Yountz

Operation Permit by: May C.O.J RS date 4-16-99

Existing System Inspection by: date

HEALTH DEPT. COPY: WHITE INSPECTION COPY (FINAL) GREEN OWNER COPY (FINAL) YELLOW INSPECTION COPY (INITIAL) PINK OWNER COPY (INITIAL): GOLD