IREDELL COUNTY HEALTH DEPARTMENT

STATESVILLE 704-878-5305 MOORESVILLE 704-664-5281

IMPROVEMENT PERMIT / AUTHORIZATION TO CONSTRUCT / OPERATION PERMIT / EXISTING SYSTEM INSPECTION

PERMIT# 130941 PIN# 4726828~~345~~ 268 DATE 8-31-05

OWNER OR CONTRACTOR Samuel G Scott PHONE: Business 704-902-3230 Home 702873 1391

ADDRESS 2278 S. Chipley Ford Rd Statesville NC

LOCATION 115 N @ Scotsdale Rd - 89 left across from bowman

SUBDIVISION Cross Creek BLOCK / SECTION III LOT 34 LOT AREA _____ SITE CLASS. RS DESIGN FLOW 360 L.T.A.R. 13

Septic Tank: 1000 Gallons; STB 10 12 Date 08-05
Pump Tank: _____ Gallons; PT _____ Date _____
Pump Make: _____ Model _____ Serial No. _____
Nitrification Field: No Fields ____ Square Feet 1200 Linear Feet 300
No Lines 3 Trench Width 36" Max Trench Bottom Depth 36 Gravel Depth N/A

☑ New System ☐ Repair System Type: I II III IV V VI
System Description: 25% - Copy
Repair System Description: 25% Copy
Maintenance Agreement Required: ☐ Yes ☑ No


☑ House/Mod. Home No. Bedrooms 3
☐ Mobile Home No. Bathrooms ____
☐ Business No. Employees ____
☐ Other _____
☐ Slab ☑ Crawl Space ☐ Basement w/plumbing ☐ Basement wo/plumbing

Water Supply: ☐ Individual ☑ Public ☐ Community

Comments:/Conditions: Install on Contour
Maintain setbacks

Comments:/Conditions:
Yellow Pipe Inlet
Septic Tank Risers

INITIAL SITE SKETCH

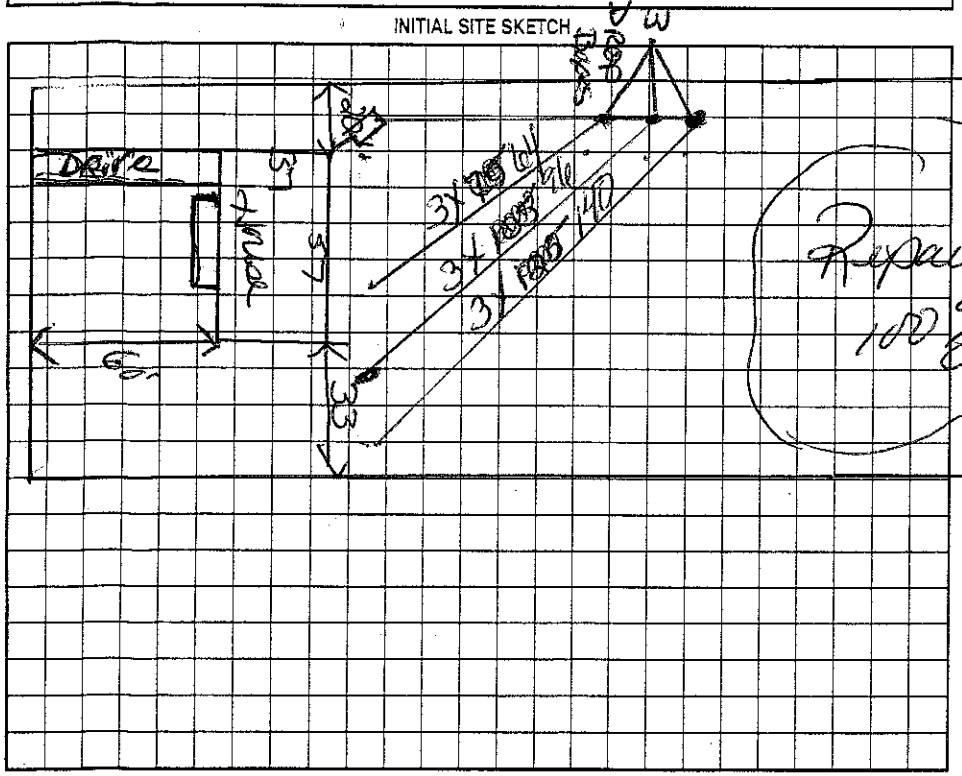

AS BUILT SKETCH

Permit can be suspended or revoked if any false information is supplied toward securing the permit/any unauthorized changes are made to the site/any unauthorized changes are made in the installation of the system. Improvement Permit with plat valid without expiration. Improvement Permit with site plan valid for sixty months. Authorization to Construct is valid for a period equal to that of Improvement Permit – not to exceed sixty months.

Signed: _____ date 9-1-05 Installed by: DAVID Lowe

Improvement Permit by: _____ date 8-31-05 Operation Permit by: _____ date 2-2-06

Authorization to Construct by: _____ date 8-31-05 Existing System Inspection by: _____ date _____

HEALTH DEPT. COPY: WHITE OWNER COPY (FINAL): YELLOW OWNER COPY (INITIAL): PINK