IREDELL COUNTY HEALTH DEPARTMENT

STATESVILLE 704-878-5305 MOORESVILLE 704-664-5281

50300

IMPROVEMENT PERMIT / CERTIFICATE OF COMPLETION / OPERATION PERMIT / EXISTING SYSTEM INSPECTION

PROPERTY DESCRIPTION NO. 17816 DATE 2/15/94 TAX MAP NO. 9A-8-A-25 Watershed: ☐ Yes ☑ No

OWNER OR CONTRACTOR TIMOTHY P. HOPE PHONE: Business Home 871-1193

ADDRESS RT-17 BOX 532 STATESVILLE, NC 28677

LOCATION NC 115 N TO SCOTTS CREEK ROAD, ON (R) AT BROOKHOLLOW DR NORTH EAST CORNER

SUBDIVISION BROOKHOLLOW BLOCK / SECTION LOT 25 LOT AREA 0.75 AC SITE CLASS. PS DESIGN FLOW 360 L.T.A.R. 0.4 GPD (D.W.)

Septic Tank: 1000 Gallons; STB 797 Date 4/16/94

Pump Tank: Gallons; PT Date

Pump Make: Model Serial No.

Nitrification Field: No Fields 1 Square Feet 900 Linear Feet 300

No Lines 8 Trench Width 36" Max Trench Bottom Depth 18-36" Gravel Depth 12"

☑ New System ☐ Repair System Type: I, II, III, IV, V, VI

System Description: CONV. GRAVITY

Repair System Description: CONV. GRAVITY

Maintenance Agreement Required: ☐ Yes ☑ No

☑ House/Mod. Home No. Bedrooms 3

☐ Mobile Home No. Bathrooms 2

☐ Business No. Employees

☐ Other


☐ Slab ☑ Crawl Space ☐ Basement w/plumbing ☐ Basement wo/plumbing

Water Supply: ☐ Individual ☐ Community ☑ Public


Comments: (1) KEEP SYSTEM MINIMUM 5' FROM HOUSE, 10' FROM PROPERTY LINE (2) INSTALL LINES ON CONTOUR NO DEEPER THAN 36", 9' APART O.C. (3) USE SERIAL DISTRIBUTION

Comments: LAYOUT CHANGED DUE TO DRIVEWAY.

INITIAL SITE SKETCH

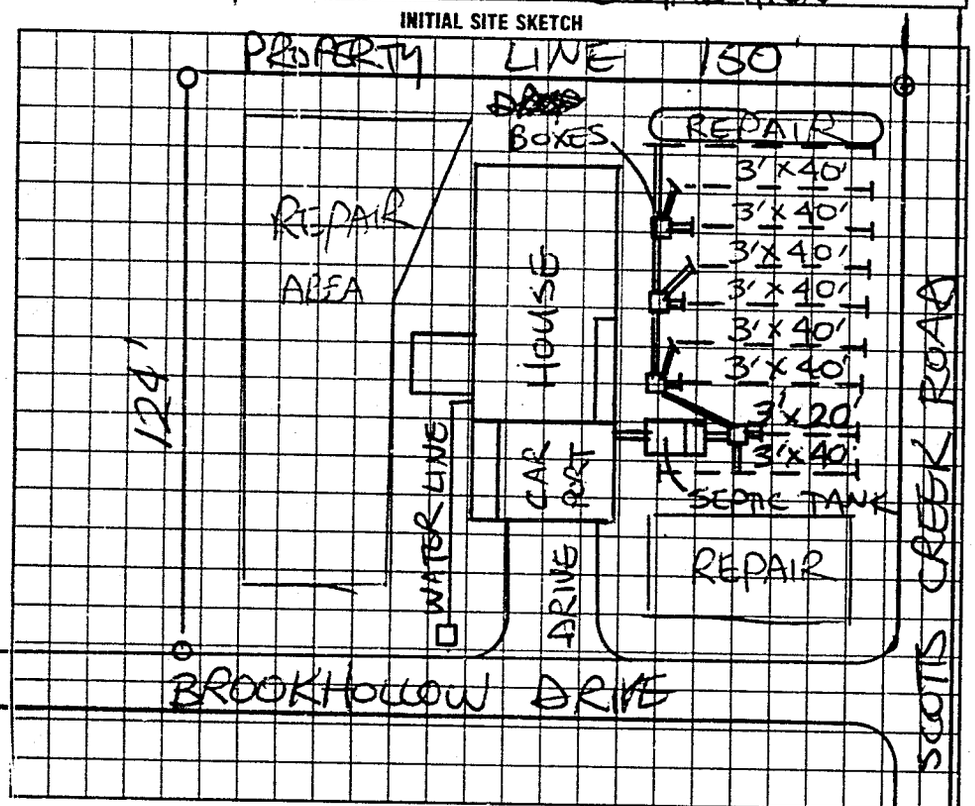

AS BUILT SKETCH

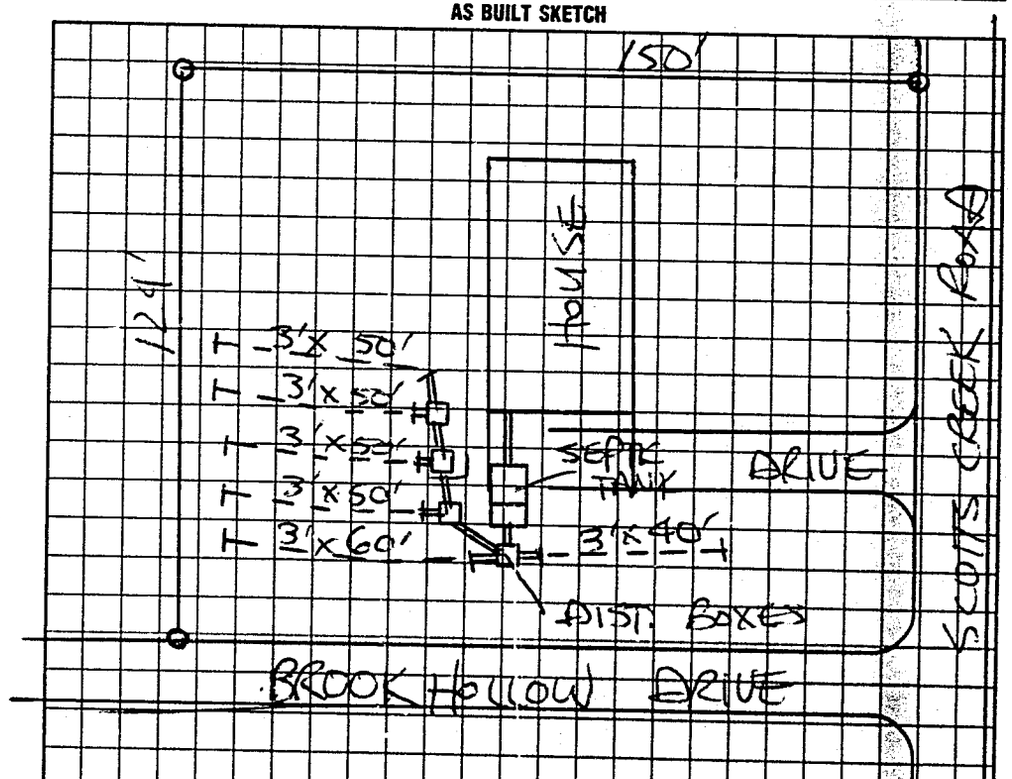

I understand that this permit can be suspended or revoked if any false information is supplied toward securing the permit/any unauthorized changes are made to the site/any unauthorized changes are made in the installation of the system. Improvement Permit is valid for 60 months from date of issuance.

Signed: T Timothy P Hope

Improvement Permit by: STEVE HEDRICK date 2/15/94

Existing System Inspection by: date

Installed by: A-1 BACKHOE

Certificate of Completion by: STEVE HEDRICK date 5/19/94

Operation Permit by: date

HEALTH DEPT COPY: WHITE INSPECTION COPY (FINAL): GREEN OWNER COPY (FINAL): YELLOW INSPECTION COPY (INITIAL): PINK OWNER COPY (INITIAL): GOLD