# IREDELL COUNTY HEALTH DEPARTMENT

STATESVILLE 704-878-5305 MOORESVILLE 704-664-5281

54974

## IMPROVEMENT PERMIT / CERTIFICATE OF COMPLETION / OPERATION PERMIT / EXISTING SYSTEM INSPECTION

PROPERTY DESCRIPTION NO. 20579 DATE 3/20/95 TAX MAP NO. 9A-5-A.14 Watershed: ☐ Yes ☒ No

OWNER OR CONTRACTOR TIM HOPE PHONE: Business _____ Home 881-1944

ADDRESS 105 HollowBrook Ct. STATESVILLE, NC 28677

LOCATION NC115 N, TL SCOTTS CREEK RD, TR ~~HollowBrd~~ BROOKHOLLOW RD, AT END ON RIGHT

SUBDIVISION BROOKHOLLOW BLOCK / SECTION _____ LOT 14 LOT AREA 151x176x109x122 SITE CLASS. PS DESIGN FLOW 360 L.T.A.R. 0.4 GPD/ft² (per D.W.)

Septic Tank: 1000 Gallons; STB _____ Date _____

Pump Tank: _____ Gallons; PT _____ Date _____

Pump Make: _____ Model _____ Serial No. _____

Nitrification Field: No Fields 1 Square Feet 900 Linear Feet 300

No Lines 3 Trench Width 36" Max Trench Bottom Depth 18-36 Gravel Depth 12

☒ New System ☐ Repair System Type: I, II, III, IV, V, VI

System Description: CONVENTIONAL GRAVITY

Repair System Description: CONV. GRAVITY

Maintenance Agreement Required: ☐ Yes ☒ No

☒ House/Mod. Home No. Bedrooms 3

☐ Mobile Home No. Bathrooms 2

☐ Business No. Employees _____

☐ Other _____


☐ Slab ☐ Crawl Space ☒ Basement w/plumbing ☐ Basement wo/plumbing

Water Supply: ☐ Individual ☐ Community ☒ Public

Comments:

Comments:

INITIAL SITE SKETCH

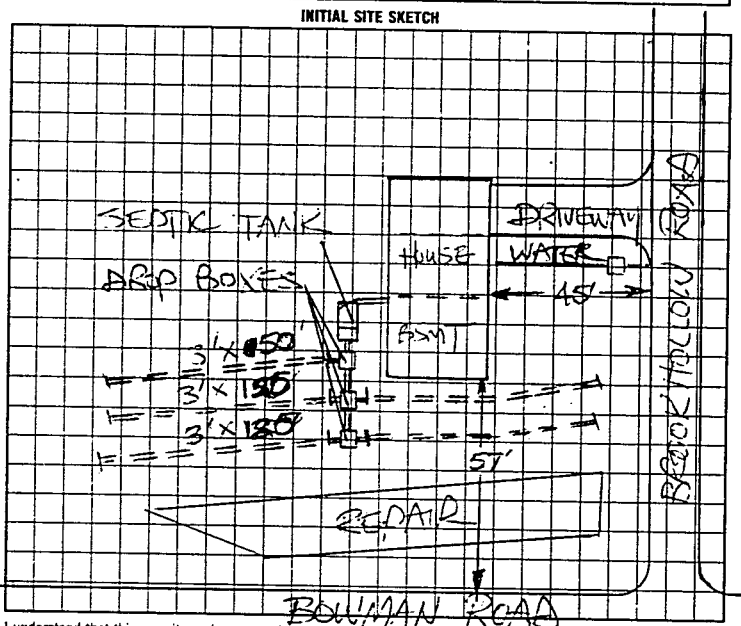


AS BUILT SKETCH

Same as initial Sketch

I understand that this permit can be suspended or revoked if any false information is supplied toward securing the permit/any unauthorized changes are made to the site/any unauthorized changes are made in the installation of the system. Improvement Permit is valid for 60 months from date of issuance.

Signed: X Jim Hope

Improvement Permit by: STEVE HEDRICK date 3/20/95

Existing System Inspection by: _____ date _____

Installed by: Andy Daniels

Certificate of Completion by: _____ date _____

Operation Permit by: K. C. Moore date 4-4-96

HEALTH DEPT. COPY: WHITE INSPECTION COPY (FINAL): GREEN OWNER COPY (FINAL): YELLOW INSPECTION COPY (INITIAL): PINK OWNER COPY (INITIAL): GOLD