62099

IREDELL COUNTY HEALTH DEPARTMENT

STATESVILLE 704-878-5305 MOORESVILLE 704-664-5281

IMPROVEMENT PERMIT / CERTIFICATE OF COMPLETION / OPERATION PERMIT / EXISTING SYSTEM INSPECTION

PROPERTY DESCRIPTION NO. 23785-02299 DATE 7-20-96 TAX MAP NO. 9A-8-A-50 Watershed: ☐ Yes ☒ No

OWNER OR CONTRACTOR TIM HOPE PHONE: Business _____ Home 881-1944

ADDRESS P.O. BOX 5882, STATESVILLE NC 28677

LOCATION NC 115 N TO SCOTT CREEK RD, TR BOWMAN, ON RIGHT AT BROOK RUN RD.

SUBDIVISION BROOKHAVEN BLOCK / SECTION _____ LOT 50 LOT AREA LIMITED SITE CLASS. PS DESIGN FLOW 360 L.T.A.R. 0.8 GPD/FT²

Septic Tank: 1000 Gallons; STB 1007 Date 8-18-97

Pump Tank: _____ Gallons; PT _____ Date _____

Pump Make: _____ Model _____ Serial No. _____

Nitrification Field: No Fields 1 Square Feet 750 TO 900 Linear Feet 225+

No Lines 3 Trench Width 36" Max Trench Bottom Depth 36" Gravel Depth N/A

☒ New System ☐ Repair System Type: I II III IV V VI

System Description: CHAMBERED GRAVITY

Repair System Description: CHAMBERED PUMP

Maintenance Agreement Required: ☐ Yes ☒ No

☒ House/Mod. Home No. Bedrooms 3

☐ Mobile Home No. Bathrooms 2

☐ Business No. Employees ____

☐ Other _____


☐ Slab ☐ Crawl Space ☐ Basement w/plumbing ☐ Basement wo/plumbing

Water Supply: ☐ Individual ☐ Community ☒ Public


Comments: INSTALL 38 CHAMBERS IN THREE LINES AS SHOWN USING SERIAL DISTRIBUTION

Comments:

INITIAL SITE SKETCH

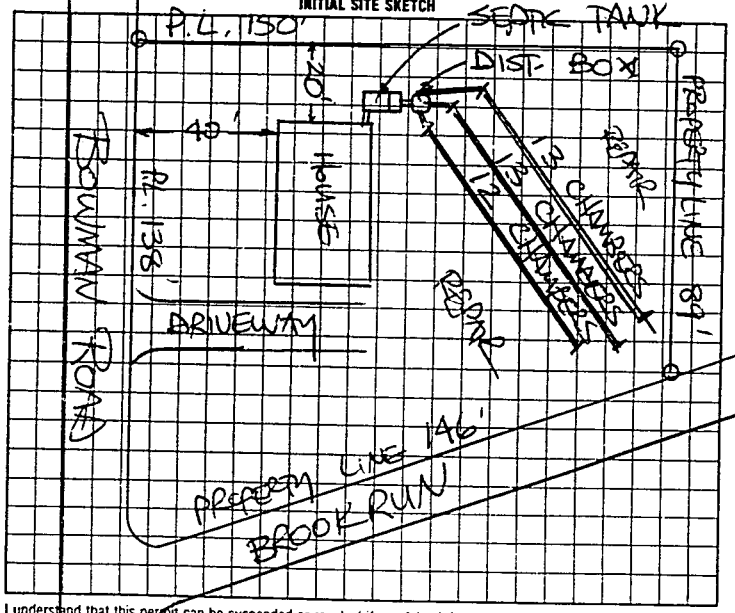

AS BUILT SKETCH

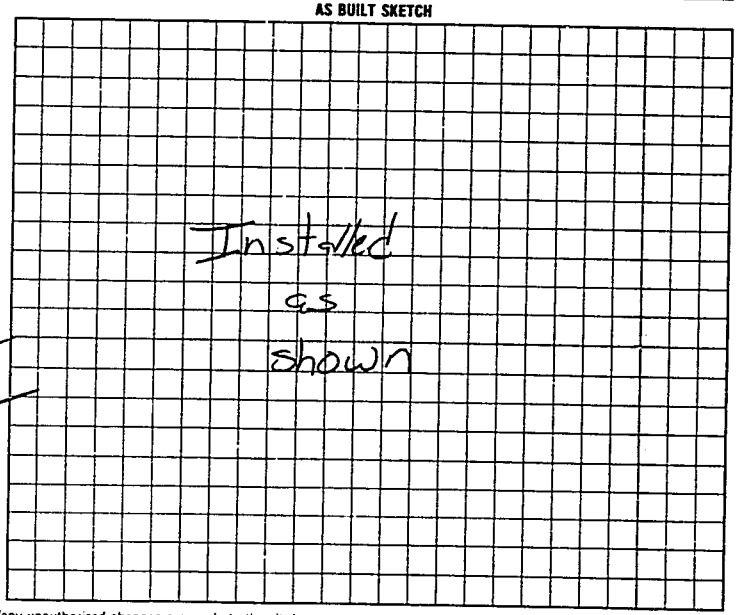

I understand that this permit can be suspended or revoked if any false information is supplied toward securing the permit/any unauthorized changes are made to the site/any unauthorized changes are made in the installation of the system.

Authorization to construct is valid five (5) years from date of issuance. Improvement Permit has no expiration date.

Signed: _____

Improvement Permit by: STEVE HENDRICK date 7-20-96 Installed by: Andy Daniels

Existing System Inspection by: STEVE HENDRICK date 7-20-96 Certificate of Completion by: _____ date _____

AUTHORIZATION TO CONSTRUCT: _____ Operation Permit by: _____ date 10-1-97

HEALTH DEPT COPY WHITE INSPECTION COPY (FINAL) GREEN OWNER COPY (FINAL) YELLOW INSPECTION COPY (INITIAL) PINK OWNER COPY (INITIAL) GOLD