IREDELL COUNTY HEALTH DEPARTMENT

STATESVILLE 704-878-5305 MOORESVILLE 704-664-5281

51503

IMPROVEMENT PERMIT / CERTIFICATE OF COMPLETION / OPERATION PERMIT / EXISTING SYSTEM INSPECTION

PROPERTY DESCRIPTION NO. 18583 DATE 5/27/94 TAX MAP NO. 9A-8-A-7 Watershed: ☐ Yes ☒ No

OWNER OR CONTRACTOR TIM HOPE PHONE: Business Home 871-1193

ADDRESS RT-17, BOX 532, STVL, NC 28677

LOCATION NC 115 N, R SCOTTS CREEK RD, R BOWMAN RD, 1ST LOT ON (L)

SUBDIVISION BROOKHOLLOW BLOCK / SECTION LOT 7 LOT AREA 100'x150' SITE CLASS. PS DESIGN FLOW 360 L.T.A.R. 0.40 GPD (PREVIOUS)

Septic Tank: 1000 Gallons; STB 1194 Date 6-11-94

Pump Tank: Gallons; PT Date

Pump Make: Model Serial No.

Nitrification Field: No Fields 1 Square Feet 900 Linear Feet 300

No Lines 6 Trench Width 36" Max Trench Bottom Depth 36" Gravel Depth 12"

☒ New System ☐ Repair System Type: I, (II), III, IV, V, VI

System Description: CONV. GRAVITY

Repair System Description: CONV. GRAVITY

Maintenance Agreement Required: ☐ Yes ☒ No

☒ House/Mod. Home No. Bedrooms 3

☐ Mobile Home No. Bathrooms 2

☐ Business No. Employees

☐ Other


☐ Slab ☒ Crawl Space ☐ Basement w/plumbing ☐ Basement wo/plumbing

Water Supply: ☐ Individual ☐ Community ☒ Public

Comments: (1) KEEP SYSTEM MINIMUM 5' FROM HOUSE, 10' FROM PROPERTY LINE, 10' FROM WATER LINE (2) INSTALL LINES ON CONTOUR, NO DEEPER THAN 36", 9' APART ON CENTER.

Comments:

INITIAL SITE SKETCH

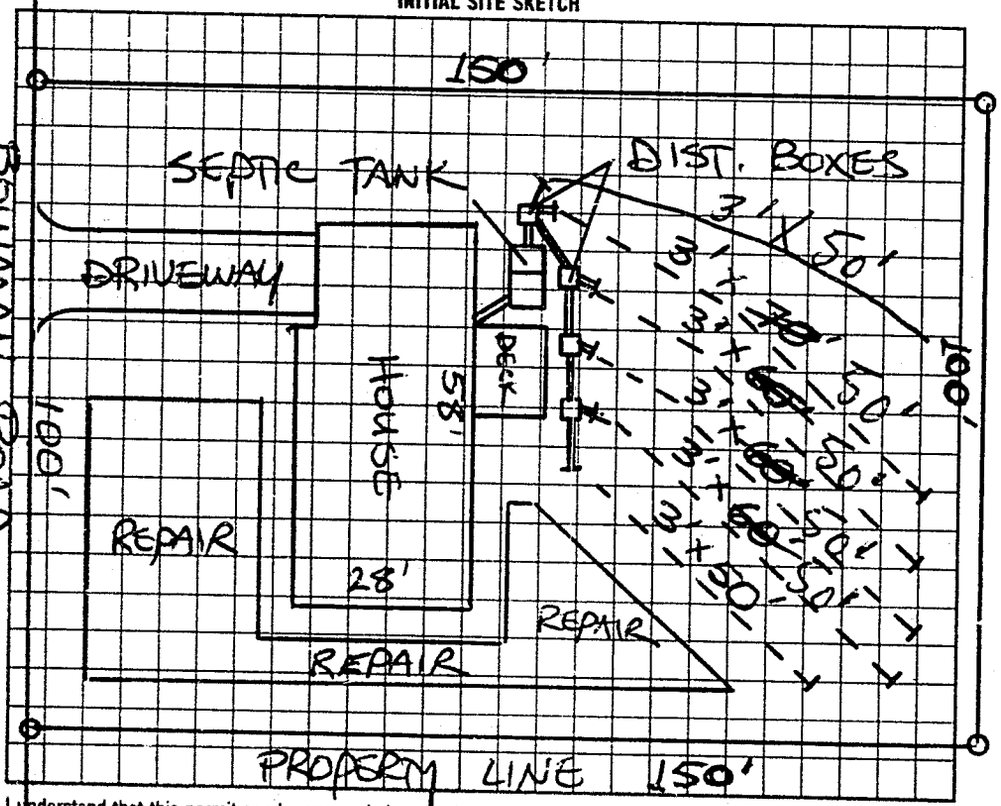

AS BUILT SKETCH

same as initial sketch

I understand that this permit can be suspended or revoked if any false information is supplied toward securing the permit/any unauthorized changes are made to the site/any unauthorized changes are made in the installation of the system. Improvement Permit is valid for 60 months from date of issuance.

Signed: Jimmy Hope

Improvement Permit by: STEVE HENDRICK date 5/27/94

Existing System Inspection by: date

Installed by: A-1 Backhoe

Certificate of Completion by: P. C. Moore date 9-15-94

Operation Permit by: date

HEALTH DEPT. COPY: WHITE INSPECTION COPY (FINAL): GREEN OWNER COPY (FINAL): YELLOW INSPECTION COPY (INITIAL): PINK OWNER COPY (INITIAL): GOLD