IREDELL COUNTY HEALTH DEPARTMENT

STATESVILLE 704-878-5305 MOORESVILLE 704-664-5281

61132

IMPROVEMENT PERMIT / CERTIFICATE OF COMPLETION / OPERATION PERMIT / EXISTING SYSTEM INSPECTION

PROPERTY DESCRIPTION NO. 23514 DATE 5-29-96 TAX MAP NO. 9A-8-A-42 Watershed: ☐ Yes ☒ No

OWNER OR CONTRACTOR TIM HOPE PHONE: Business _____ Home 881-1944

ADDRESS P.O. BOX 5882 STATESVILLE, NC 28687

LOCATION NC 115N, TL SCOTTS CREEK RD, TR BOWMAN RD, ON Right AT BROOK RUN

SUBDIVISION BROOKHOLLOW BLOCK / SECTION _____ LOT 42 LOT AREA 0.3694 AC SITE CLASS. PS DESIGN FLOW 360 L.T.A.R. 0.46AD (D.W.)

Septic Tank: 1000 Gallons; STB WINGATE Date 1-20-97

Pump Tank: _____ Gallons; PT _____ Date _____

Pump Make: _____ Model _____ Serial No. _____

Nitrification Field: No Fields 1 Square Feet 900 Linear Feet 300

No Lines 5 A Trench Width 36" Max Trench Bottom Depth 18-36" Gravel Depth 12"

☒ New System ☐ Repair System Type: ☐ I ☒ II ☐ III, IV, V, VI

System Description: CONV. GRAVITY

Repair System Description: CONV. GRAVITY

Maintenance Agreement Required: ☐ Yes ☒ No

☒ House/Mod. Home No. Bedrooms 3

☐ Mobile Home No. Bathrooms 2

☐ Business No. Employees ____

☐ Other _____


☐ Slab ☒ Crawl Space ☐ Basement w/plumbing ☐ Basement wo/plumbing

Water Supply: ☐ Individual ☐ Community ☒ Public


Comments:

Comments: SYSTEM ALTERED AS SHOWN

INITIAL SITE SKETCH

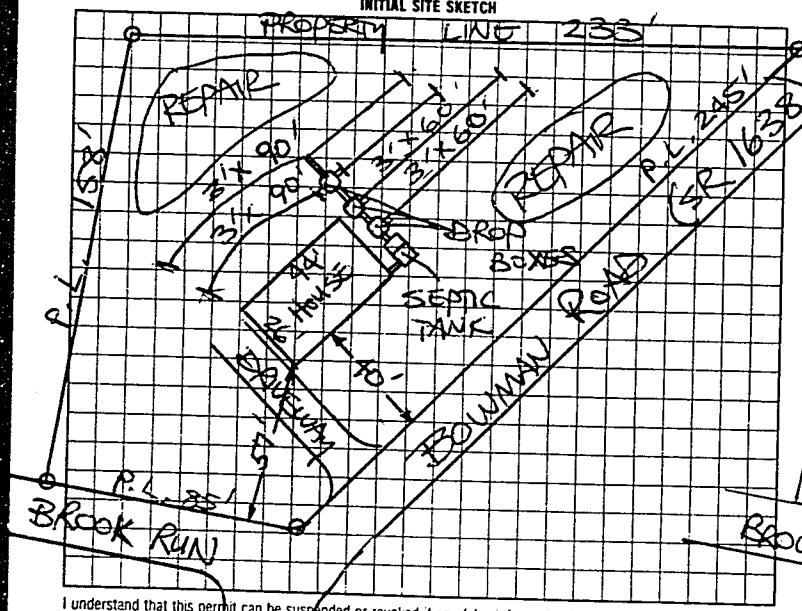

AS BUILT SKETCH

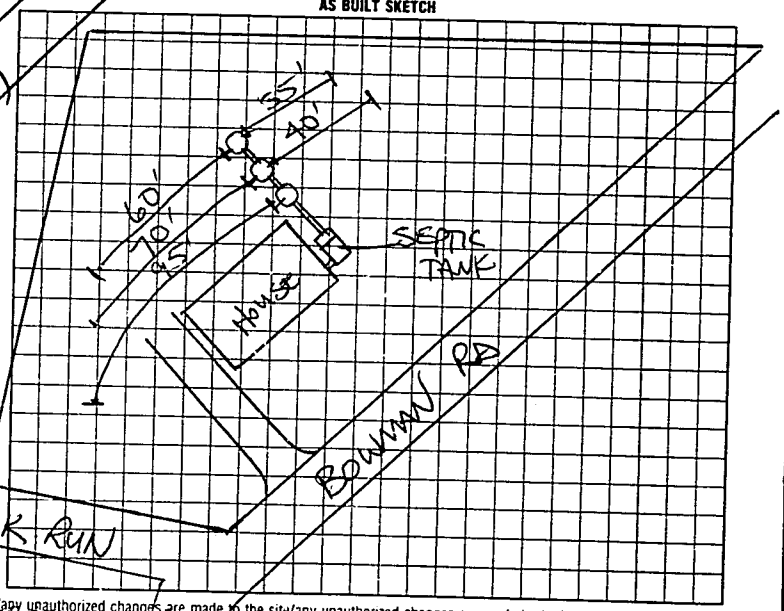

I understand that this permit can be suspended or revoked if any false information is supplied toward securing the permit/any unauthorized changes are made to the site/any unauthorized changes are made in the installation of the system.

Authorization to Construct is valid five (5) years from date of issuance. / Improvement Permit has no expiration date.

Signed: _____

Improvement Permit by: STEVE HENRICK date 5-29-96

Existing System Inspection by: _____ date _____

AUTHORIZATION TO CONSTRUCT: STEVE HENRICK date 5-29-96

Installed by: ANDY DANIELS

Certificate of Completion by: _____ date _____

Operation Permit by: STEVE HENRICK date 3-21-97

HEALTH DEPT COPY: WHITE INSPECTION COPY (FINAL) GREEN OWNER COPY (FINAL) YELLOW INSPECTION COPY (INITIAL) PINK OWNER COPY (INITIAL) GOLD