IREDELL COUNTY HEALTH DEPARTMENT

STATESVILLE 704-878-5305 MOORESVILLE 704-664-5281

IMPROVEMENT PERMIT / AUTHORIZATION TO CONSTRUCT / OPERATION PERMIT / EXISTING SYSTEM INSPECTION

PERMIT# 72643 PIN# 4726 84 3449 DATE 5-21-98

OWNER OR CONTRACTOR Jim wooten PHONE: Business 873-1990 Home

ADDRESS 2267 Old Wilkesboro Rd Sta

LOCATION 232 Bowman Rd 115N To Scotts Creek Rd TR Bowman Rd at end

SUBDIVISION Brook Hollow BLOCK / SECTION LOT 59 LOT AREA .61 acres SITE CLASS. PS DESIGN FLOW 240 L.T.A.R. 13

Septic Tank: 1000 Gallons; STB 794 Date 4-29-98

Pump Tank: Gallons; PT Date

Pump Make: Model Serial No.

Nitrification Field: No Fields 4 Square Feet 810 Linear Feet 270

No Lines 4 Trench Width 36" Max Trench Bottom Depth 36" Gravel Depth 12"

☑ New System ☐ Repair System Type: I, II, III, IV, V, VI

System Description: Conv. Gravity

Repair System Description: Gravity Chamber

Maintenance Agreement Required: ☐ Yes ☑ No

☐ House/Mod. Home No. Bedrooms 2

☑ Mobile Home No. Bathrooms 2

☐ Business No. Employees

☐ Other


☐ Slab ☑ Crawl Space ☐ Basement w/plumbing ☐ Basement wo/plumbing

Water Supply: ☐ Individual ☑ Public ☐ Community


Comments:/Conditions:

Comments:/Conditions:

INITIAL SITE SKETCH

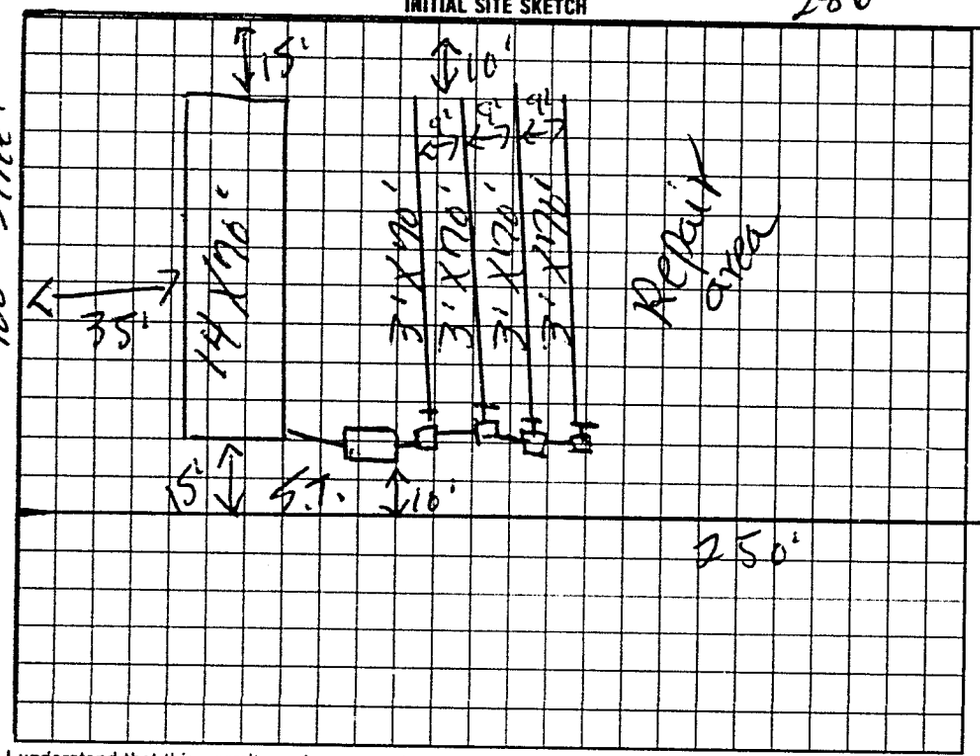

AS BUILT SKETCH

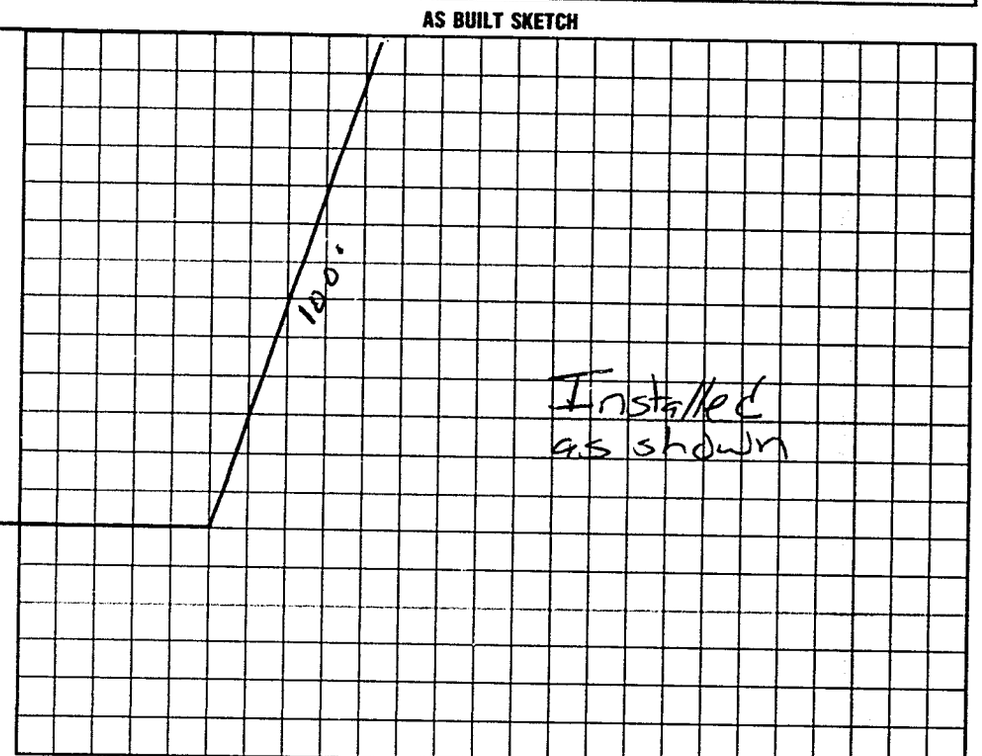

I understand that this permit can be suspended or revoked if any false information is supplied toward securing the permit/any unauthorized changes are made to the site/any unauthorized changes are made in the installation of the system. Improvement Permit with plat valid without expiration. Improvement Permit with site plan valid for sixty months. Authorization to Construct is valid for a period equal to that of Improvement Permit – not to exceed sixty months.

Signed: Jim Wooten date 5-27-98 Installed by: James Hucker

Improvement Permit by: B. C. Moore date 5-21-98 Operation Permit by: Will for Cnty RS date 7-21-98

Authorization to Construct by: B. C. Moore date 5-21-98 Existing System Inspection by date

HEALTH DEPT. COPY WHITE INSPECTION COPY (FINAL) GREEN OWNER COPY (FINAL) YELLOW INSPECTION COPY (INITIAL) PINK OWNER COPY (INITIAL) GOLD