IREDELL COUNTY HEALTH DEPARTMENT

STATESVILLE 704-878-5305 MOORESVILLE 704-664-5281

IMPROVEMENT PERMIT / AUTHORIZATION TO CONSTRUCT / OPERATION PERMIT / EXISTING SYSTEM INSPECTION

PERMIT# 72644 PIN# 4768444448 DATE 5-21-98

OWNER OR CONTRACTOR Jim Wooten PHONE: Business Home 873 1990

ADDRESS 2262 Old Wilkesboro Rd Sta.

LOCATION 236 Bowman Rd 1.15 N TL Scotts Rd TR Bowman Rd at End

SUBDIVISION Brook Hollow BLOCK / SECTION LOT 60 LOT AREA .59 acres SITE CLASS. PS DESIGN FLOW 240 L.T.A.R. .26

Septic Tank: 1000 Gallons; STB 794 Date 4-27-98

Pump Tank: Gallons; PT Date

Pump Make: Model Serial No.

Nitrification Field: No Fields 1 Square Feet 900 Linear Feet 300

No Lines 4 Trench Width 36" Max Trench Bottom Depth 30" Gravel Depth 12"

☑ New System ☐ Repair System Type: I, II, III, IV, V, VI

System Description: Conv. Gravity

Repair System Description: Gravity Chambers

Maintenance Agreement Required: ☐ Yes ☑ No

☐ House/Mod. Home ☑ Mobile Home ☐ Business ☐ Other

No. Bedrooms 2 No. Bathrooms 2 No. Employees


Water Supply: ☐ Individual ☑ Public ☐ Community

☐ Slab ☑ Crawl Space ☐ Basement w/plumbing ☐ Basement wo/plumbing


Comments:/Conditions:

Comments:/Conditions:

INITIAL SITE SKETCH

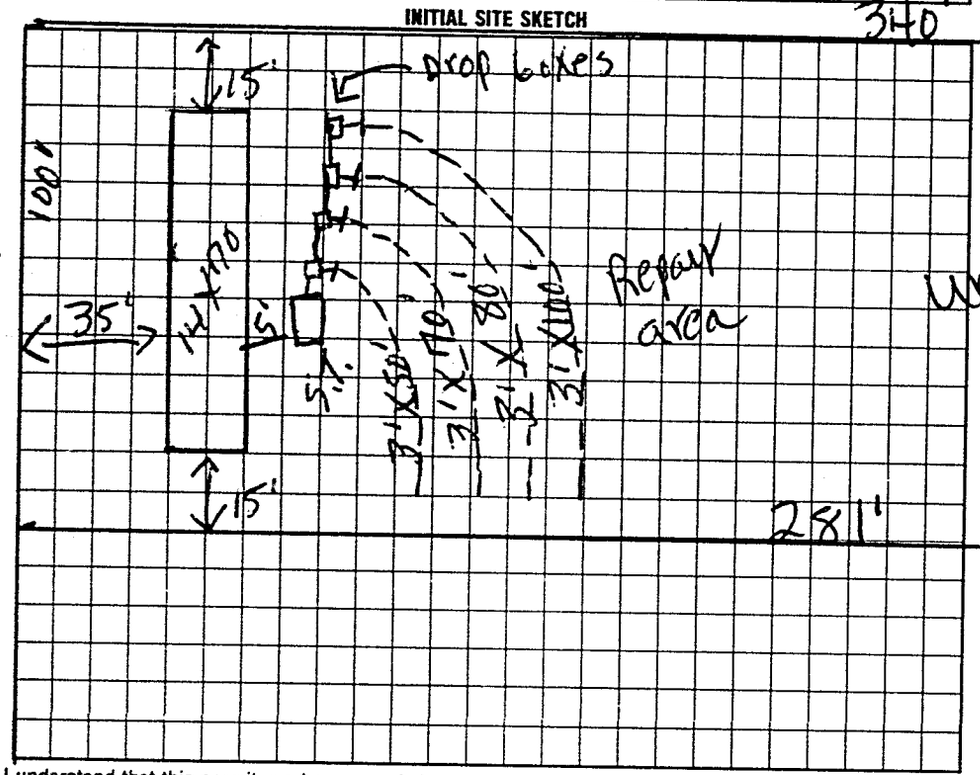

AS BUILT SKETCH

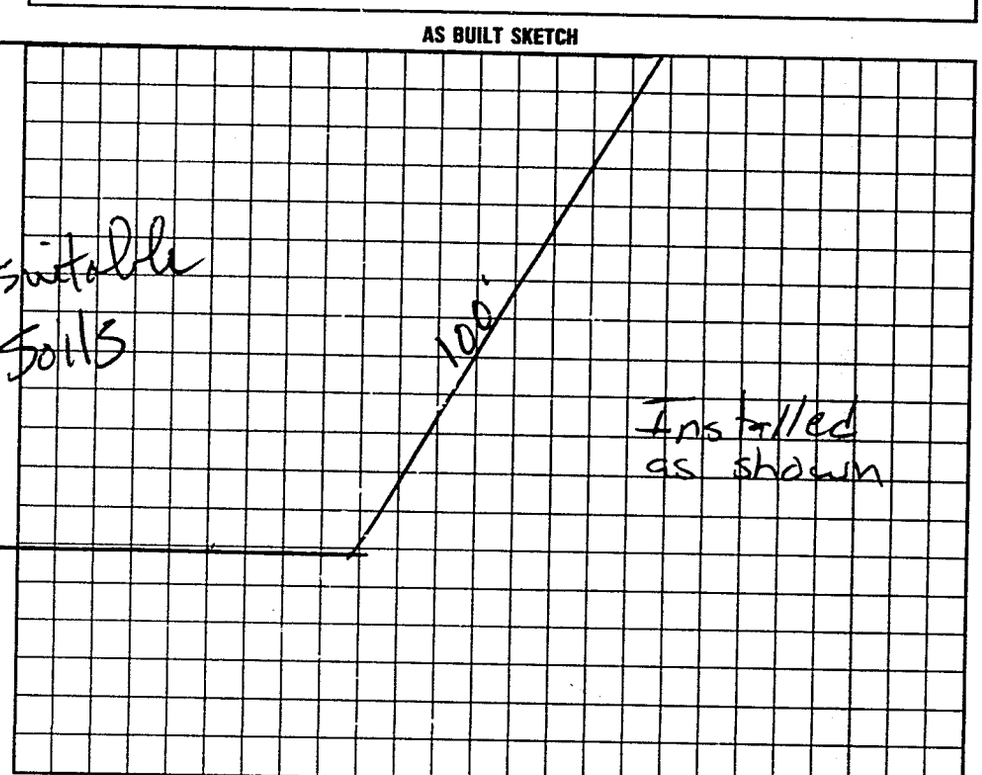

I understand that this permit can be suspended or revoked if any false information is supplied toward securing the permit/any unauthorized changes are made to the site/any unauthorized changes are made in the installation of the system. Improvement Permit with plat valid without expiration. Improvement Permit with site plan valid for sixty months. Authorization to Construct is valid for a period equal to that of Improvement Permit – not to exceed sixty months.

Signed: Jim Wooten date 5-27-98

Improvement Permit by: L.C. Moore date 5-21-98

Authorization to Construct by: L.C. Moore date 5-21-98

Installed by: James Hudler

Operation Permit by: 9/1 of CO. + 15 date 7-21-98

Existing System Inspection by: date

HEALTH DEPT. COPY: WHITE INSPECTION COPY (FINAL): GREEN OWNER COPY (FINAL): YELLOW INSPECTION COPY (INITIAL): PINK OWNER COPY (INITIAL): GOLD