IREDELL COUNTY HEALTH DEPARTMENT

STATESVILLE 704-878-5305 MOORESVILLE 704-664-5281

IMPROVEMENT PERMIT / AUTHORIZATION TO CONSTRUCT / OPERATION PERMIT / EXISTING SYSTEM INSPECTION

PERMIT# 72645 PIN# 4726845459 DATE 5-21-98

OWNER OR CONTRACTOR Jim Wooten PHONE: Business Home 873 1990

ADDRESS 2262 Old Wilkesboro Rd Statesville

LOCATION 240 Bowman Rd 115N To Scotts Creek TR Bowman Rd To end

SUBDIVISION Brook Hollow BLOCK / SECTION LOT 61 LOT AREA 1.38 acres SITE CLASS. PS DESIGN FLOW 240 L.T.A.R. .3

Septic Tank: 1000 Gallons; STB 794 Date 4-23-98

Pump Tank: 1000 Gallons; PT 27 Date 5-9-98

Pump Make: Hydromatic Model SK75M2 Serial No. 5197026

Nitrification Field: No Fields 1 Square Feet 600 Linear Feet 200

No Lines 3 Trench Width 36" Max Trench Bottom Depth 36" Gravel Depth N/A

☑ New System ☐ Repair System Type: I, II, III, IV, V, VI

System Description: Pump To chambers

Repair System Description: " " "

Maintenance Agreement Required: ☐ Yes ☑ No

☐ House/Mod. Home ☑ Mobile Home ☐ Business ☐ Other

No. Bedrooms 2 No. Bathrooms 2 No. Employees

☐ Slab ☐ Crawl Space ☐ Basement w/plumbing ☐ Basement wo/plumbing


Water Supply: ☐ Individual ☑ Public ☐ Community

Comments:/Conditions:


Comments:/Conditions:

Installed as shown

INITIAL SITE SKETCH

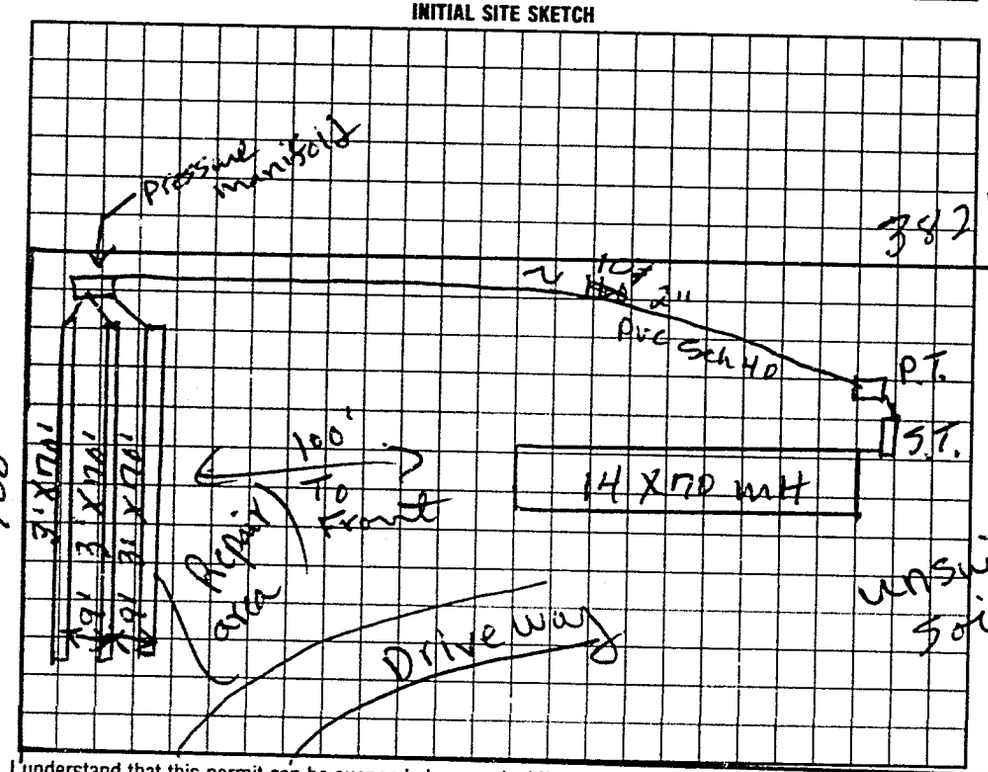

AS BUILT SKETCH

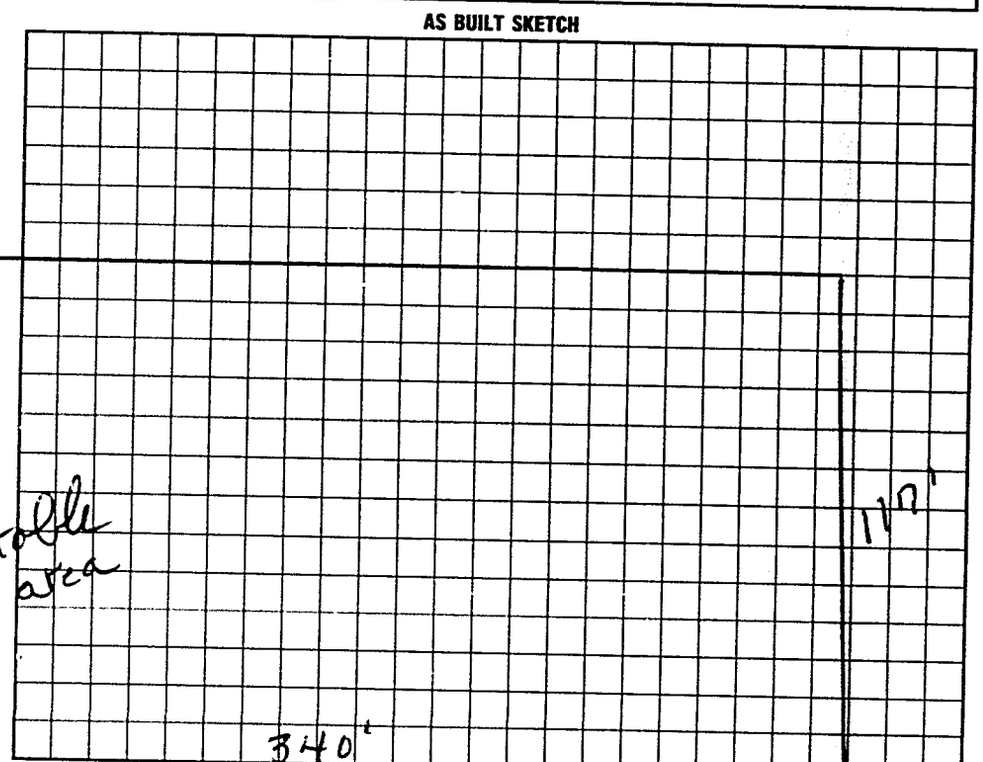

I understand that this permit can be suspended or revoked if any false information is supplied toward securing the permit/any unauthorized changes are made to the site/any unauthorized changes are made in the installation of the system. Improvement Permit with plat valid without expiration. Improvement Permit with site plan valid for sixty months. Authorization to Construct is valid for a period equal to that of Improvement Permit – not to exceed sixty months.

Signed: Jim Wooten date 5-22-98 Installed by: James Hudler

Improvement Permit by: R. C. Moore date 5-21-98 Operation Permit by: Mat C Ofs date 9-3-98

Authorization to Construct by: R. C. Moore date 5-21-98 Existing System Inspection by: date

HEALTH DEPT COPY: WHITE INSPECTION COPY (FINAL): GREEN OWNER COPY (FINAL): YELLOW INSPECTION COPY (INITIAL): PINK OWNER COPY (INITIAL): GOLD