IREDELL COUNTY HEALTH DEPARTMENT

STATESVILLE 704-878-5305 MOORESVILLE 704-664-5281

IMPROVEMENT PERMIT / AUTHORIZATION TO CONSTRUCT / OPERATION PERMIT / EXISTING SYSTEM INSPECTION

PERMIT# Repair PIN# 4726-85-7177 DATE 8-13-03

OWNER OR CONTRACTOR Hubbard PHONE: Business (704) 873-5978 Home

ADDRESS P.O. Box 2302 Statesville, NC 28687

LOCATION Hwy 15 N. past Westwind Baptist Church 1st drive past Old Lookout Rd, 6 on (R) between Power to Attic Here on Land lock

SUBDIVISION — BLOCK / SECTION — LOT — LOT AREA Acreage-4.45 SITE CLASS. 1 DESIGN FLOW 360 L.T.A.R. .30

Septic Tank: Existing Gallons; STB Date

Pump Tank: Gallons; PT Date

Pump Make: Model Serial No.

Nitrification Field: No Fields 1 Square Feet 630 Linear Feet 140

No Lines 2 @ 70' Trench Width 36" Max Trench Bottom Depth 36" Gravel Depth 18"

☐ New System ☒ Repair System Type: I (II) III, IV, V, VI

System Description:

Repair System Description: Gravity, Conventional

Maintenance Agreement Required: ☐ Yes ☒ No

☒ House/Mod. Home No. Bedrooms 3

☐ Mobile Home No. Bathrooms 1

☐ Business No. Employees

☐ Other

☐ Slab ☒ Crawl Space ☐ Basement w/plumbing ☐ Basement wo/plumbing


Water Supply: ☒ Individual ☐ Public ☐ Community

Comments/Conditions: (1) Pump out Septic Tank, check tee, replace if needed (2) Check dist. box replace if needed (3) Add two (2) lines 70ft long with 18" of gravel. (4) Call Insp. Dept if needed.


Comments/Conditions:

- 8/27/03 - Pumped Tank, replaced Septic Tee in S.T.

INITIAL SITE SKETCH

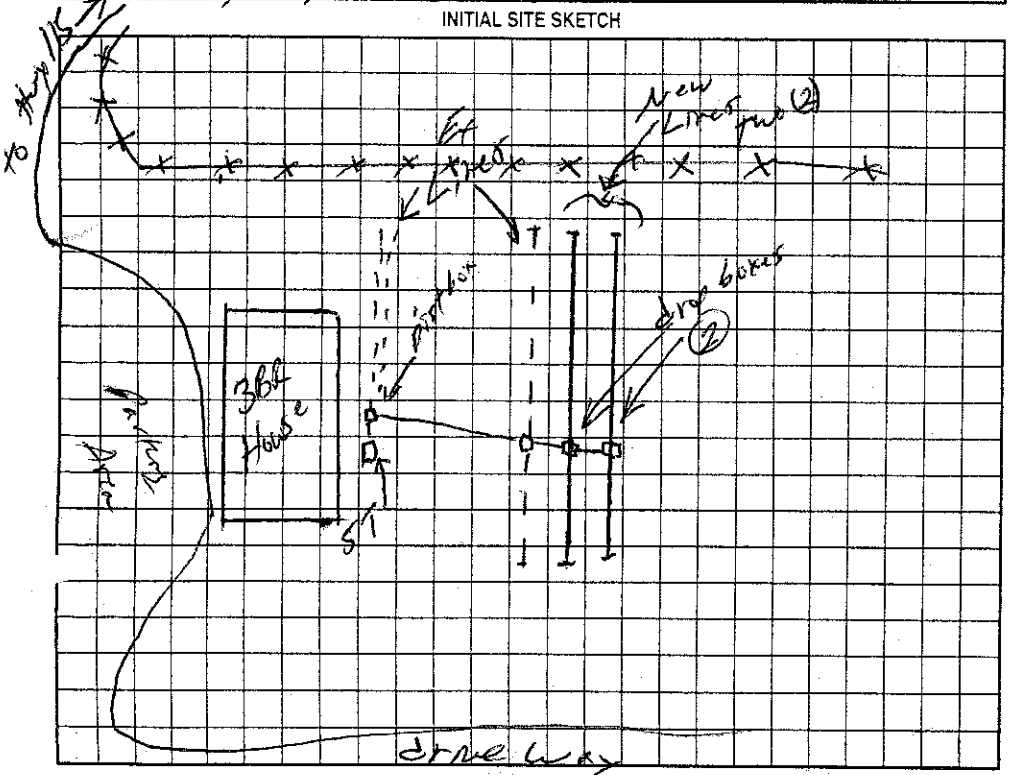

AS BUILT SKETCH

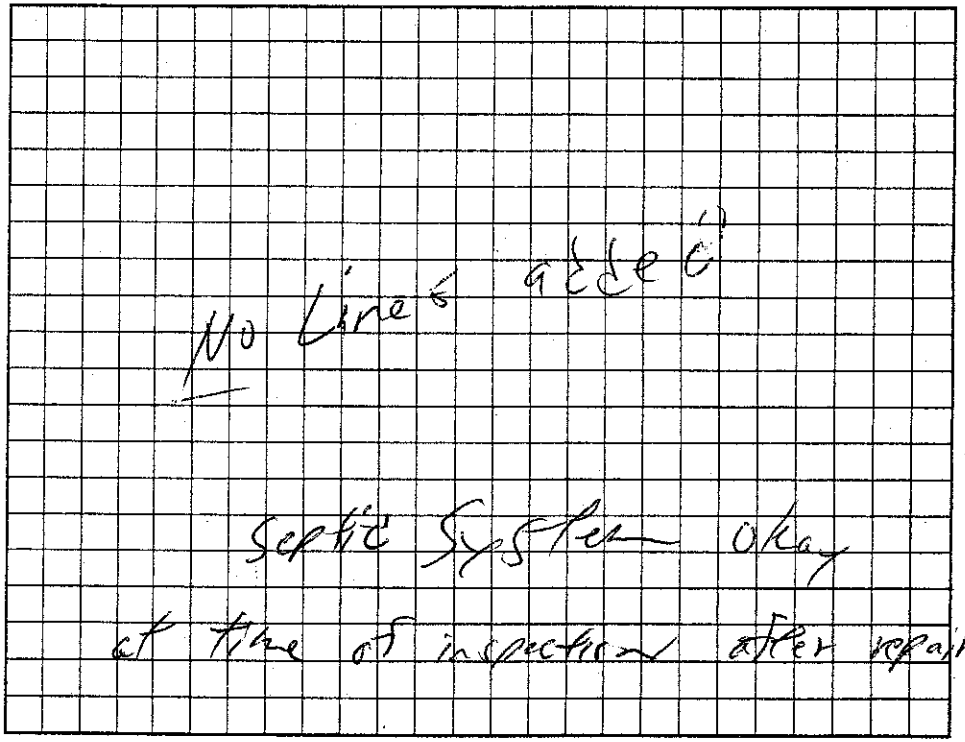

Permit can be suspended or revoked if any false information is supplied toward securing the permit/any unauthorized changes are made to the site/any unauthorized changes are made in the installation of the system. Improvement Permit with plat valid without expiration. Improvement Permit with site plan valid for sixty months. Authorization to Construct is valid for a period equal to that of Improvement Permit – not to exceed sixty months.

Signed: Jamy Johnson date 8-13-03

Improvement Permit by: William O. Johnson date 8-13-03

Authorization to Construct by: William O. Johnson date 8-13-03

Installed by: James Hasler (8/27/03)

Operation Permit by: William Johnson date 10/03

Existing System Inspection by: date

HEALTH DEPT. COPY: WHITE OWNER COPY (FINAL): YELLOW OWNER COPY (INITIAL): PINK