IREDELL COUNTY HEALTH DEPARTMENT

Statesville Phone TR 3-7271 Mooresville Phone NO 3-1271

PERMIT TO INSTALL SEPTIC TANK

Permit NO. _____ Permit Date Nov-21-1960

Owner Hubbard Poulty Farm Address Hwy # 115-

Installed By CLYDE HOKE Address _____


Location of Property Out 115 N past Marlowes-Amoco Ser. about 1 mile on left - large poulty houses -

Tank		Capacity		Length of Lines		Fixtures	
Block	( )	800	( )	150'	( )	No. of Baths	(1)
Precast	(✓)	900	( )	175'	( )	Dishwasher	( )
		1000	(✓)	200'	( )	Garbage Grdr.	( )
		1100	( )	225'	(✓)	Auto-Washer	( )
Lock		1200	( )	250'	( )	Other	_____
		Other	_____	Other	_____		

NOTIFY HEALTH DEPARTMENT AT LEAST EIGHT HOURS BEFORE TANK IS TO BE INSPECTED.

Final Inspection 11-21-1960 Approved (✓) Disapproved ( )

Remarks for egg washing house only. one stool. no well on property close - 1000 ft.

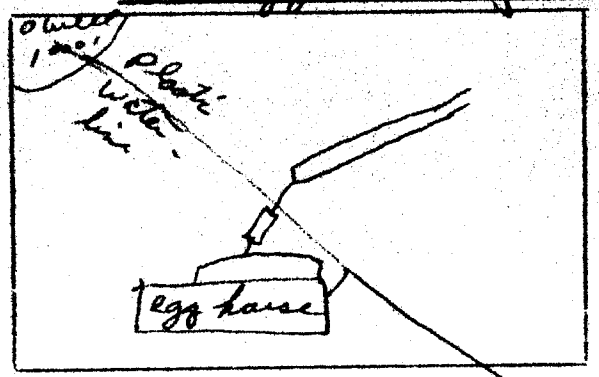

Sketch of Installation

RT

Self app

Sanitarian