IREDELL COUNTY HEALTH DEPARTMENT

(SEPTIC TANK) IMPROVEMENTS PERMIT AND CERTIFICATE OF COMPLETION

(Ground Absorption Sewage Disposal System – G. S. Chapter 130-Article 13C)

OWNER OR CONTRACTOR True Temple Church of God DATE 10/20/77 PERMIT NO. _____

PHONE: Business _____ Home _____

LOCATION Hwy 115 N Past Hubbard Farms - Flat Top Church On L. as you start down the hill

SUBDIVISION NAME _____ S. R. No. _____

LOT NO. _____ SECTION OR BLOCK NO. _____

House ( ) Mobile Home ( ) Business ( ) Other Church - 30 Members

No. Bedrooms _____ No. Bathrooms 1

Garbage Disposal Unit	Yes ( )	No ( )
Auto. Dishwasher	Yes ( )	No ( )
Auto. Wash. Machine	Yes ( )	No ( )
Site Suitable	Yes ( )	No ( )

Lot Area _____


Character & Porosity of Soil _____

Percolation Rate _____

Topography _____

Depth to Water Table Existing Bldg.

Rock or other impervious formations _____

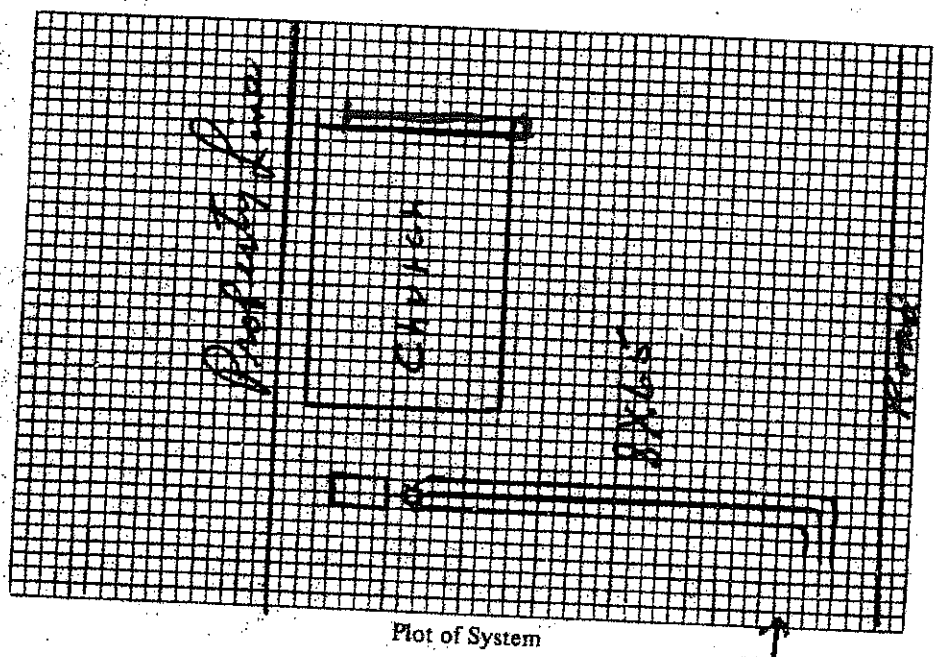

Plot of System

Size of Tank 1000 Gals.

Nitrification Field:

No. of Lines 3

Sq. Ft. 520 Linear Ft. 195

Depth of Stone in Lines 16"

Water Supply: Individual (✓)

Public ( )

Next Door

Installed by Culbreson

Bathroom added to Existing Building
1 - Lavatory
1 - Commode

IMPROVEMENTS PERMIT BY _____

COMMENTS: This system was not put in as laid out by Health Dept. Is short of square ft. but should take care of this bldg OK

CERTIFICATE OF COMPLETION BY E. A. Culbreson DATE 10/20/77

CONSTRUCTION MUST COMPLY WITH ALL OTHER APPLICABLE STATE AND LOCAL REGULATIONS.

Health Dept. C

Location of the proposed HANDICAP RAMP addition does not appear to impact the existing on-site septic system.**NOTE:

R. STEVE HEDRICK REHS

Date: 9-6-12

ICHD-Environmental Health Division

Owner's Copy: Gold