CW

ICHD - ENVIRONMENTAL HEALTH DIVISION

Statesville Office (704) 878-5305 Mooresville Office (704) 660-3625

PERMIT # OSWP-2023-17418

SEPTIC: IMPROVEMENT PERMIT / AUTHORIZATION TO CONSTRUCT / OPERATION PERMIT / EXISTING SYSTEM / Repair

PIN # 4726-86-9930

APPLICANT / OWNER: Lentz Wastewater Management, Inc

APPLICANT ADDRESS: 463 Lentz Road, Statesville, NC 28625

SITE ADDRESS: 137 CROSBY RD, STATESVILLE, NC 28625

PHONE: (980) 829-3278

ALT. PHONE: –

SITE DIRECTIONS: (L) Stockton, (R) Gordon, (R) E Water St

SAP CONTROLLED: ~~YES~~ ☐ NO ☐

SUBDIVISION: –

SECTION: –

LOT #: –

LOT AREA: .43Ac


DESIGN FLOW: 240

L.T.A.R.: –


Septic Tank: (gal) 1000	STB: 760	Date: 7-21-23	☐ New System ☑ Repair ☐ Expansion	System Type: II	☑ Residence	No. Bedrooms: 2	Water Supply: Existing Well
Pump Tank: (gal)	PT:	Date:	System Description: –		☐ Business	No. Persons: 4	
Pump Make:	Model:	Serial #:	Repair System Description: Tank Replacement		☐ Other	No. Employees:	
# Nitrification Fields: Ext	# Lines: Ext	Linear Ft.: Ext	Maintenance Agreement Required: ☐ YES ☑ NO		☐ Slab	☑ Crawl Space	
Trench Width: Ext	Trench Bottom Depth (Low side): Ext		Gravel Depth: N/A	☑ GRAVITY ☐ PRESSURE	☐ Basement w/ Plumbing	☐ Basement w/o Plumbing	

Comments / Conditions: Pump, crush, fill collapsed tank. Place new tank where full can be achieved and in the same hole as old tank

INITIAL SITE SKETCH

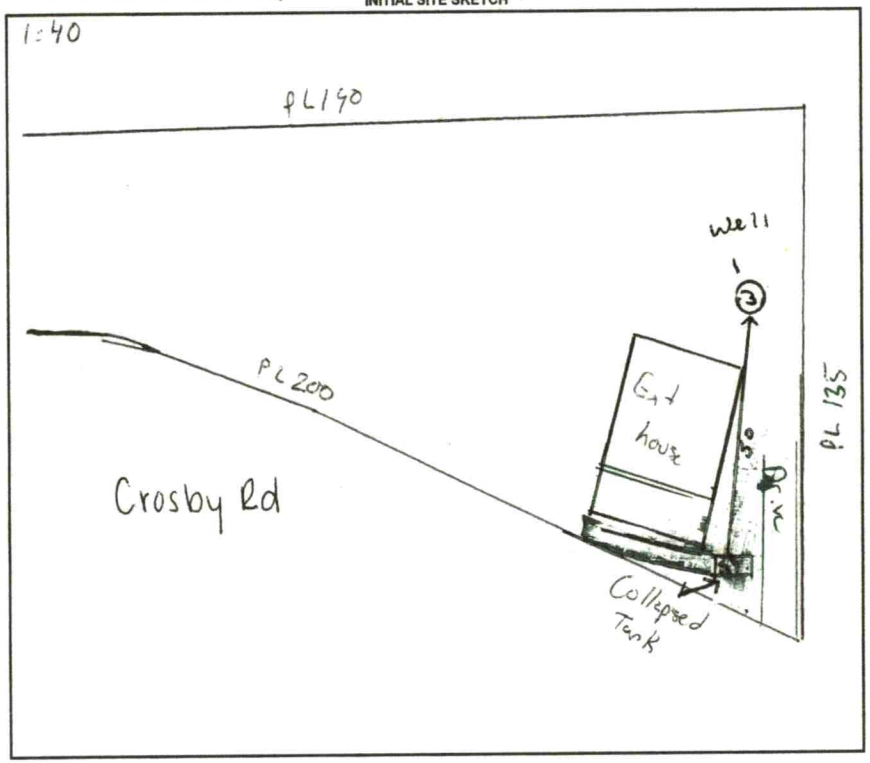

AS BUILT SKETCH

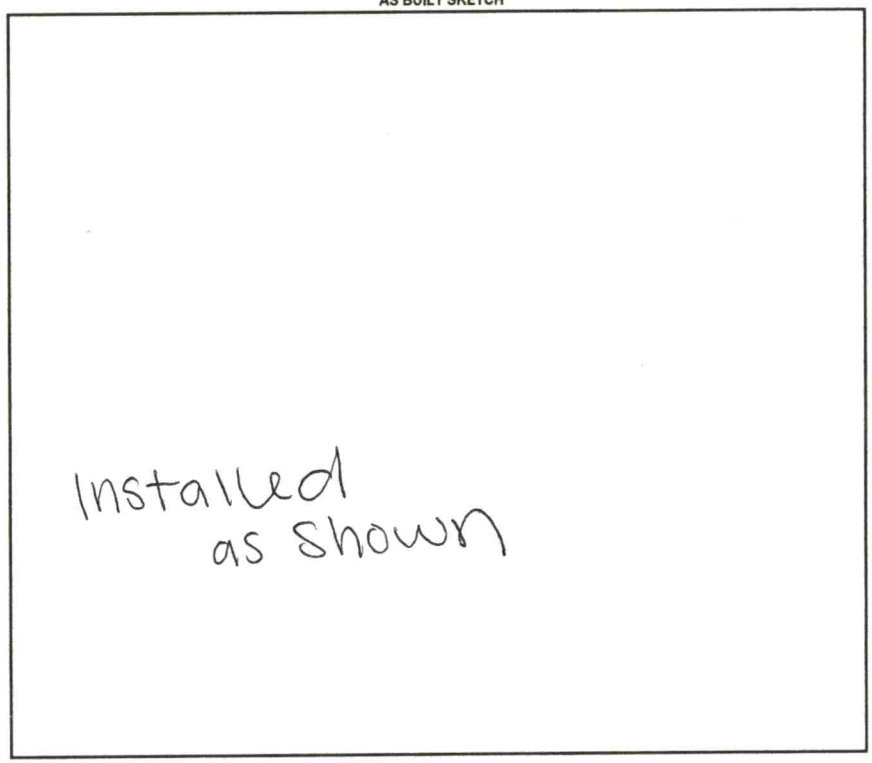

Permit can be suspended or revoked if any false information is supplied toward securing the permit / any unauthorized changes are made to the site / any unauthorized changes are made in the installation of the system. CONTACT A LOCATOR SERVICE PRIOR TO ANY EXCAVATION

☐ IMPROVEMENT PERMIT with plat valid without expiration. ☑ IMPROVEMENT PERMIT with site plan valid for 60 mos. ☑ AUTHORIZATION TO CONSTRUCT valid for period equal to IMPROVEMENT PERMIT--not to exceed 60 mo.

Owner / Applicant Signature: _____ Date: _____

IMPROVEMENT PERMIT by: [signature] Date: 3/15/23

AUTHORIZATION TO CONSTRUCT by: [signature] Date: 3/15/23

Installed By: Lentz

OPERATION PERMIT by: Sydney Howard Date: 8/30/23

Existing System Inspected By: _____ Date: _____

FOR SEPTIC FINAL INSPECTION CALL: 704-664-3703 BETWEEN 8am-9am the day the inspection is needed.

CW

ICHD - ENVIRONMENTAL HEALTH DIVISION

Statesville Office (704) 878-5305 Mooresville Office (704) 660-3625

PERMIT # OSWP-2023-17418

SEPTIC: IMPROVEMENT PERMIT / AUTHORIZATION TO CONSTRUCT / OPERATION PERMIT / EXISTING SYSTEM

PIN # 4726-86-9930

APPLICANT / OWNER: Lentz Wastewater Management, Inc | APPLICANT ADDRESS: 463 Lentz Road, Statesville, NC 28625

SITE ADDRESS: 137 CROSBY RD, STATESVILLE, NC 28625 | PHONE: (980) 829-3278 | ALT. PHONE: –


SITE DIRECTIONS: (L) Stockton, (R) Gordon, (R) E Water St | SAP CONTROLLED: ~~YES~~ ☐ NO ☐

SUBDIVISION: – | SECTION: – | LOT #: – | LOT AREA: .43Ac | DESIGN FLOW: 240 | L.T.A.R.: –

Septic Tank: (gal) 1000	STB:	Date:	☐ New System ☑ Repair ☐ Expansion	System Type: II	☑ Residence	No. Bedrooms: 2	Water Supply: Existing Well
Pump Tank: (gal)	PT:	Date:	System Description: –		☐ Business	No. Persons: 4	
Pump Make:	Model:	Serial #:	Repair System Description: Tank Replacement		☐ Other	No. Employees:	
# Nitrification Fields: Ext	# Lines: Ext	Linear Ft.: Ext	Maintenance Agreement Required: ☐ YES ☑ NO		☐ Slab	☑ Crawl Space	
Trench Width: Ext	Trench Bottom Depth (Low side): Ext		Gravel Depth: N/A	☑ GRAVITY ☐ PRESSURE	☐ Basement w/ Plumbing	☐ Basement w/o Plumbing	

Comments / Conditions: Pump, crush, fill collapsed tank. Place new tank where full can be achieved and in the same hole as old tank

INITIAL SITE SKETCH

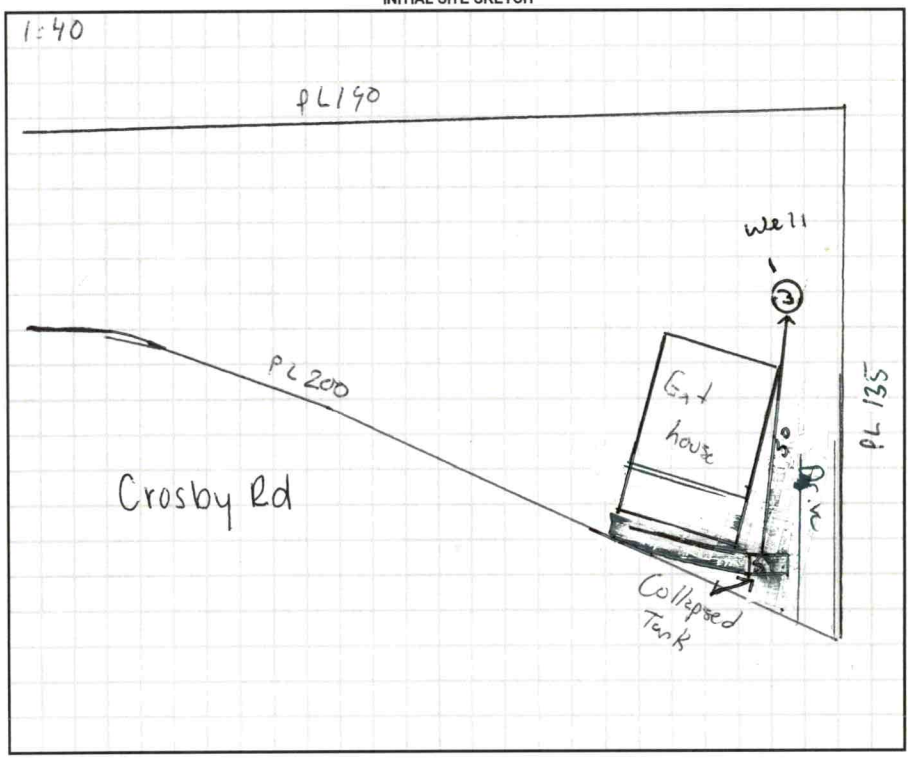

AS BUILT SKETCH

Permit can be suspended or revoked if any false information is supplied toward securing the permit / any unauthorized changes are made to the site / any unauthorized changes are made in the installation of the system. CONTACT A LOCATOR SERVICE PRIOR TO ANY EXCAVATION

☐ IMPROVEMENT PERMIT with plat valid without expiration. ☑ IMPROVEMENT PERMIT with site plan valid for 60 mos. ☑ AUTHORIZATION TO CONSTRUCT valid for period equal to IMPROVEMENT PERMIT--not to exceed 60 mo.

Owner / Applicant Signature: _____ Date: _____ Installed By: _____

IMPROVEMENT PERMIT by: _____ Date: 3/15/23 OPERATION PERMIT by: _____ Date: _____

AUTHORIZATION TO CONSTRUCT by: _____ Date: 3/15/23 Existing System Inspected By: _____ Date: _____

FOR SEPTIC FINAL INSPECTION CALL: 704-664-3703 BETWEEN 8am-9am the day the inspection is needed.



Tax Map Information

• PIN	4726869930.000
• Address	137 CROSBY RD
• Account #	Acct 80041157
• Tax Owner	MILLSAPS TAMMY M
• Mailing Address	83 MANSFIELD RD UNIT 221
•	NEW LONDON, CT 6320
• GIS Owner	MILLSAPS TAMMY M
• Deed Info	2468 / 267 - WD - 20170106
• Tax Acres	0.43 AC
• Lot #	
• Description	ELLIS SR1963
• Zoning	R20
• Old Parcel #	1009L00000A032
• Bldg Value	$840
• OBXF Value	$0
• Land Value	$8,130
• Total Value	$8,970
• Defer Value	$0
• Tax Districts	-ALLCNTY FIRE- -

IREDELL COUNTY, NC

MAP FOR REFERENCE ONLY
NOT A LEGAL DOCUMENT

Iredell County, North Carolina makes no claims and no warranties, expressed or implied, concerning the validity or accuracy of the GIS data presented on this map.

Geometry updated 02/24/2023
Data updated 02/24/2023

Print map scale is approximate. Critical layout or measurement activities should not be done using this resource.

