IREDELL COUNTY HEALTH DEPARTMENT

STATESVILLE 704-878-5305 MOORESVILLE 704-664-5281

IMPROVEMENT PERMIT / AUTHORIZATION TO CONSTRUCT / OPERATION PERMIT / EXISTING SYSTEM INSPECTION

PERMIT# 101519 PIN# 4726-90-0566 DATE 8-8-01

OWNER OR CONTRACTOR Doug McNeal PHONE: Business Home (704) 876-1696

ADDRESS 133 Fulbright Road Stony Point, NC 28678

LOCATION NC 115 N, TL Scotts Creek Rd, TL Ethel Lane, TR D.J. Drive, 3rd Lot before Cul De Sac

SUBDIVISION Woodrose BLOCK / SECTION LOT 47 LOT AREA 31,100 SF +/- SITE CLASS PS DESIGN FLOW 360 L.T.A.R. 0.30 GPD/FT²

Septic Tank: 1000 Gallons; STB ~~Fiberglass~~ Date 4-27-02

Pump Tank: Gallons; PT Date

Pump Make: Model Serial No.

Nitrification Field: No Fields 1 Square Feet 60 TO 1200 Linear Feet 300+

No Lines Four Trench Width 36" Max Trench Bottom Depth 36" Gravel Depth N/A

☒ New System ☐ Repair System Type: I, II, III, IV, V

System Description: 25% Reduction Gravity

Repair System Description: 25% Reduction, Gravity

Maintenance Agreement Required: ☐ Yes ☒ No

☒ House/Mod. Home No. Bedrooms 3

☐ Mobile Home No. Bathrooms 2

☐ Business No. Employees

☐ Other


☐ Slab ☒ Crawl Space ☐ Basement w/plumbing ☐ Basement wo/plumbing

Water Supply: ☐ Individual ☒ Public ☐ Community


Comments/Conditions: Install 25% Reduction System using Fifty (50) chambers or Thirty (30) HDS sections on contour, as shown

Comments/Conditions: Tuff-Tite Filter Installed

INITIAL SITE SKETCH

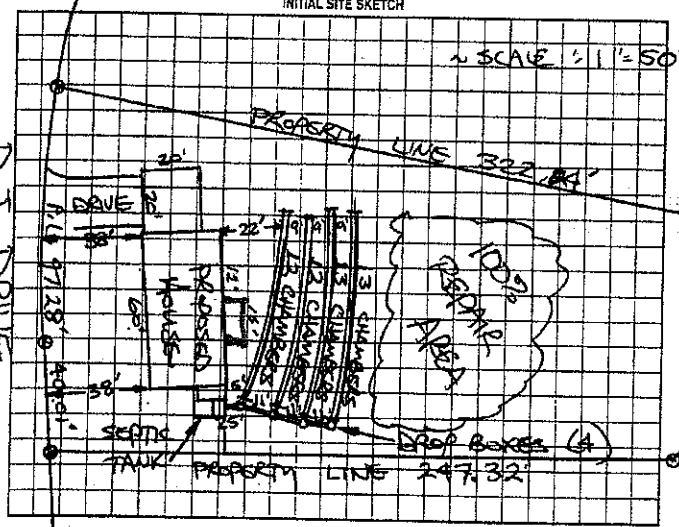

AS BUILT SKETCH

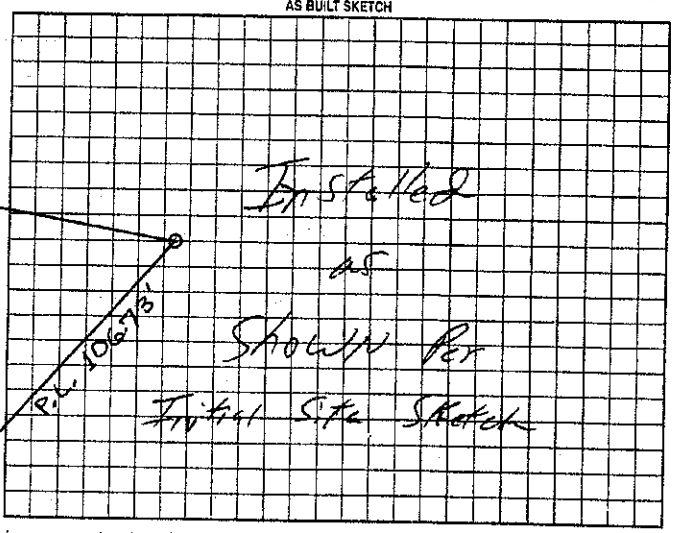

Permit can be suspended or revoked if any false information is supplied toward securing the permit/any unauthorized changes are made to the site/any unauthorized changes are made in the installation of the system. Improvement Permit with plat valid without expiration. Improvement Permit with site plan valid for sixty months. Authorization to Construct is valid for a period equal to that of Improvement Permit – not to exceed sixty months.

Signed: X Doug McNeal date 8-8-01 Installed by: Tommy Frye

Improvement Permit by: Steve Hedrick date 8-8-01 Operation Permit by: William O. Johnson date 9/6/02

Authorization to Construct by: Steve Hedrick date 8-8-01 Existing System Inspection by: date

HEALTH DEPT COPY WHITE OWNER COPY (FINAL) YELLOW OWNER COPY (INITIAL) PINK

Location of the proposed Sun room (porch close-in) addition does not appear to impact the existing on-site septic system.**NOTE:

REHS

Date: 9-18-1

ICHD-Environmental Health Division

0 0 0 5

ON LEFT