IREDELL COUNTY HEALTH DEPARTMENT

STATESVILLE 704-878-5305 MOORESVILLE 704-664-5281

IMPROVEMENT PERMIT / CERTIFICATE OF COMPLETION / OPERATION PERMIT / EXISTING SYSTEM INSPECTION

PROPERTY DESCRIPTION NO. 66516 DATE 6-2-97 TAX MAP NO. 4726900678

OWNER OR CONTRACTOR Rox Creek Flory PHONE: Business 929-0948 Home

ADDRESS 2423 Creek View Dr. Lancaster PA 17602 Watershed: ☐ Yes ☐ No

LOCATION 113 N TL Scotts Creek TL Ethel N TR D.J. 4th lot Sromens

SUBDIVISION Woodrose BLOCK / SECTION LOT 46 LOT AREA .183 acres SITE CLASS PS DESIGN FLOW 360 L.T.A.R. .33

Septic Tank: 1000 Gallons; STB 825 Date 8-21-97

Pump Tank: Gallons; PT Date

Pump Make: Model Serial No.

Nitrification Field: No Fields 1 Square Feet 1080 Linear Feet 360

No Lines 4 Trench Width 36" Max Trench Bottom Depth 36" Gravel Depth 12"

☑ New System ☐ Repair System Type: I, II, III, IV, V, VI

System Description: Conv. Gravity

Repair System Description: " "

Maintenance Agreement Required: ☐ Yes ☐ No

☑ House/Mod. Home No. Bedrooms 3

☐ Mobile Home No. Bathrooms 2

☐ Business No. Employees

☐ Other


☐ Slab ☐ Crawl Space ☐ Basement w/plumbing ☐ Basement wo/plumbing

Water Supply: ☐ Individual ☐ Community ☑ Public


Comments:

Comments:

INITIAL SITE SKETCH

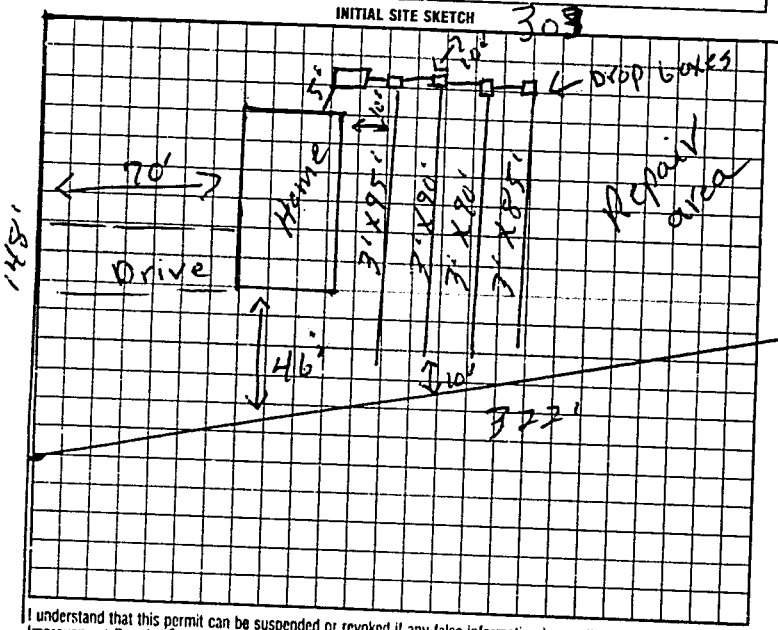

AS BUILT SKETCH

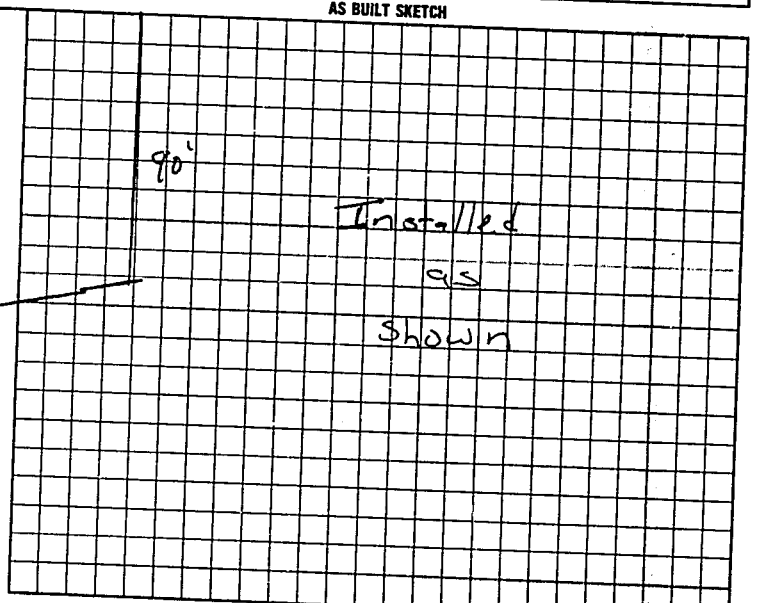

I understand that this permit can be suspended or revoked if any false information is supplied toward securing the permit/any unauthorized changes are made to the site/any unauthorized changes are made in the installation of the system. Improvement Permit is valid for 60 months from date of issuance.

Signed: X Bradford

Improvement Permit by: P.C. Moore date 6-2-97

Authorization

Existing System Inspection by: P.C. Moore date 6-2-97

to Cont.

Installed by: Wayne Clontz

Certificate of Completion by: date

Operation Permit by: date 10-16-97

HEALTH DEPT. COPY: WHITE INSPECTION COPY (FINAL): GREEN OWNER COPY (FINAL): YELLOW INSPECTION COPY (INITIAL): PINK OWNER COPY (INITIAL): GOLD

Authorization to Cont EXPIRES 60 MOS FROM ISSUE