04251

IREDELL COUNTY HEALTH DEPARTMENT

(SEPTIC TANK) IMPROVEMENTS PERMIT AND CERTIFICATE OF COMPLETION
(Ground Absorption Sewage Disposal System -- G. S. Chapter 130-Article 13C)

OWNER OR CONTRACTOR JAMES BOWERS DATE 4-29-86. PERMIT NO. _____

PHONE: Business _____ Home _____

LOCATION Hwy 115 N - T.L. on Sullivan Farm Rd. - cross over old 115 - T.L. on Ettel Dr. - 400' on R. S. R. No. _____

SUBDIVISION NAME WOODROSE PARK LOT NO. 31 SECTION OR BLOCK NO. _____


House (✓) Mobile Home ( ) Business ( ) Other _____

No. Bedrooms 3 No. Bathrooms 2

Garbage Disposal Unit Yes ( ) No (✓)
Auto. Dishwasher Yes (✓) No ( )
Auto. Wash. Machine Yes (✓) No ( )
Site Suitable Yes (✓) No ( )
Lot Area Ample

Character & Porosity of Soil Prov. Suitable.
Percolation Rate 4 gal./sq. ft.
Topography 2-6%
Depth to Water Table 10'+
Rock or other impervious formations none observed.

_____ Basement with Plumbing _____ Basement without Plumbing ✓ No Basement

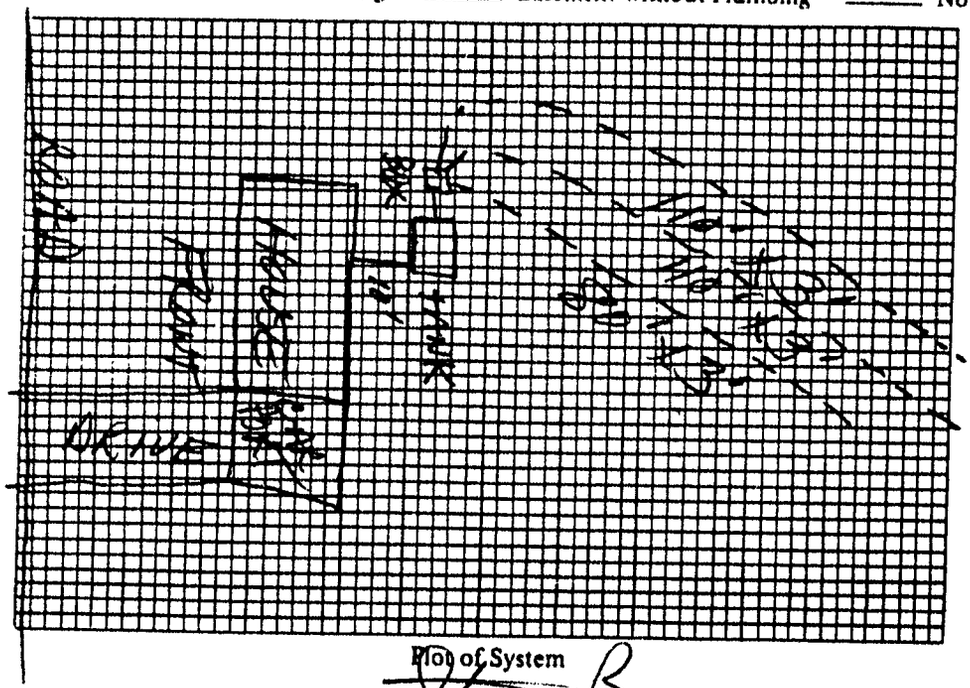

Plan of System

Size of Tank 1000 Gals.
Nitrification Field:
No. of Lines 3
Sq. Ft. 900 Linear Ft. 300
Depth of Stone in Lines 12"
Water Supply: Individual ( )
Public (✓)

Installed by _____

I understand and agree to install septic tank system as specified on this Improvements Permit.

Signed: _____

IMPROVEMENTS PERMIT BY Steve Brown

COMMENTS: _____

CERTIFICATE OF COMPLETION BY Steve Brown DATE 4-29-86.

EXISTING SYSTEM CHECKED BY: _____ DATE _____

CONSTRUCTION MUST COMPLY WITH ALL OTHER APPLICABLE STATE AND LOCAL REGULATIONS.

Permit is VOID if any unauthorized changes are made in installation of system and/or if any false information is supplied in making Improvements Permit.

Health Dept. Copy: White Inspection Dept. Copy: Yellow Sanitarian's Copy: Pink Owner's Copy: Gold