11:30 2:00

THIS PERMIT REPLACES PREVIOUS ISSUED 6-24-06

IREDELL COUNTY HEALTH DEPARTMENT

STATESVILLE 704-878-5305 MOORESVILLE 704-664-5281

IMPROVEMENT PERMIT / AUTHORIZATION TO CONSTRUCT / OPERATION PERMIT / EXISTING SYSTEM INSPECTION

PERMIT# 136609 PIN# 4726-91-8194 DATE 8-22-06

OWNER OR APPLICANT BILLY FRANKLIN LITTLE, JR PHONE: Business 704-880-3068 Home

ADDRESS 1014 PERTH ROAD, TROUTMAN, NC 28166

LOCATION NC 115 NORTH, TL SCOTTS CREEK ROAD, TL ETHEL LANE, LOT ON LEFT AT BOX #155

SUBDIVISION WOODROSE BLOCK / SECTION LOT 12 LOT AREA 0.638 ACRE SITE CLASS. PS DESIGN FLOW 360 L.T.A.R. 0.30 GPD/FT2

Septic Tank: 1000 Gallons: STB 760 Date 10-21-7

Pump Tank: Gallons: PT Date

Pump Make: Model Serial No.

Nitrification Field: No Fields 1 Square Feet EQ. P 1200 Linear Feet 200

No Lines Four Trench Width 24" Max Trench Bottom Depth 36" Gravel Depth 24"

☑ New System ☐ Repair ☐ Expansion System Type: I II III IV V VI

System Description: 50% REDUCTION GRAVITY

Repair System Description: 50% REDUCTION LOW PRESSURE

Maintenance Agreement Required: ☐ Yes ☑ No

☑ House/Mod. Home ☐ Mobile Home ☐ Business ☐ Other

No. Bedrooms 3 No. Persons No. Employees


Water Supply: ☐ Individual ☑ Public ☐ Community

☑ Gravity ☐ Pressure ☐ Slab ☑ Crawl Space ☐ Basement w/plumbing ☐ Basement wo/plumbing


Comments/Conditions: ① KEEP WATER LINE ON RIGHT PROPERTY LINE SIDE of DRIVEWAY ② INSTALL 50% REDUCTION SYSTEM USING 48 PDRPS PANELS & EQUAL DISTRIBUTION W/ EFFLUENT SPLITTER

Comments/Conditions:

INITIAL SITE SKETCH

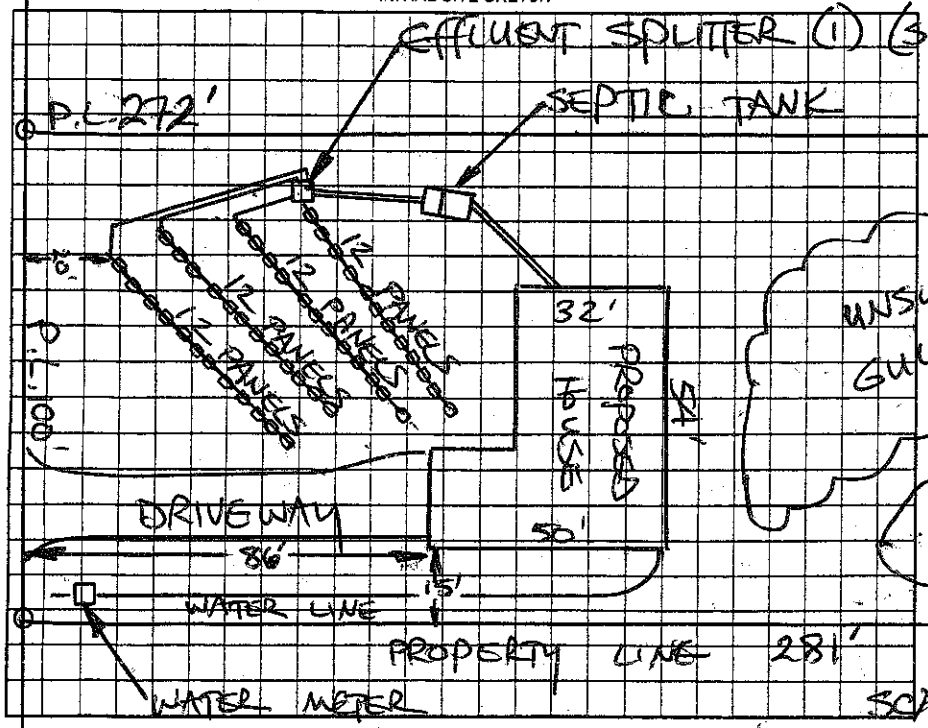

AS BUILT SKETCH

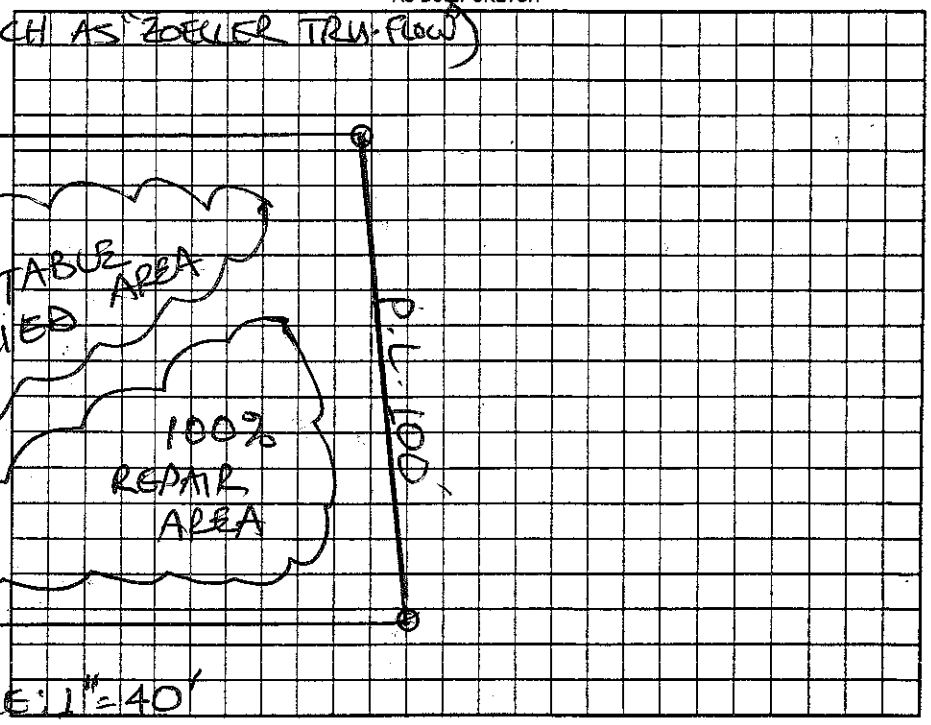

ETHEL LANE

Permit can be suspended or revoked if any false information is supplied toward securing the permit/any unauthorized changes are made to the site/any unauthorized changes are made in the installation of the system. Improvement Permit with plat valid without expiration. ☐ Improvement Permit with site plan valid for sixty months ☑ Authorization to Construct is valid for a period equal to that of Improvement Permit – not to exceed sixty months.

Signed: Ted Mowrey date 5-22-06 Installed by: Brent Gaither

Improvement Permit by: STEVE HENDRICK date 8-22-06 Operation Permit by: date 1-30-07

Authorization to Construct by: STEVE HENDRICK date 8-22-06 Existing System Inspection by: date

HEALTH DEPT. COPY: WHITE OWNER COPY (FINAL): YELLOW OWNER COPY (INITIAL): PINK