# IREDELL COUNTY HEALTH DEPARTMENT

STATESVILLE 704-878-5305 MOORESVILLE 704-664-5281

## IMPROVEMENT PERMIT / AUTHORIZATION TO CONSTRUCT / OPERATION PERMIT / EXISTING SYSTEM INSPECTION

PERMIT# 07187 PIN# 4726923277 DATE 2-12-98

OWNER OR CONTRACTOR STANDARD BUILDING Co, PHONE: Business 929-0948 Home 585-2211

ADDRESS 202 HARRIS BRIDGE ROAD, STONY POINT, NC 28678

LOCATION NC 115 N, TL SCOTTS CREEK, TL ETHEL, TR DJ TR FRIENDLY CIRCLE, AT END ON RIGHT

SUBDIVISION WOODRIDGE PARK BLOCK / SECTION ____ LOT 74 LOT AREA 27,600 FT² SITE CLASS PS DESIGN FLOW 360 L.T.A.R. 0.30 GPD/FT²

Septic Tank: 1000 Gallons; STB 825 Date 10-21-98
Pump Tank: ____ Gallons; PT ____ Date ____
Pump Make: ____ Model ____ Serial No. ____
Nitrification Field: No Fields 1 Square Feet 50 TO 1200 Linear Feet 380+
No Lines FOUR Trench Width 36" Max Trench Bottom Depth 36" ~~Gravel~~ Depth SAND 6"

☑ New System ☐ Repair System Type: I, II, III, IV, V, VI
System Description: CHAMBERED GRAVITY
Repair System Description: CHAMBERED PUMP,
Maintenance Agreement Required: ☐ Yes ☑ No

☑ House/Mod. Home No. Bedrooms 3
☐ Mobile Home No. Bathrooms 2
☐ Business No. Employees ____
☐ Other ____


☐ Slab ☑ Crawl Space ☐ Basement w/plumbing ☐ Basement wo/plumbing

Water Supply: ☐ Individual ☑ Public ☐ Community

Comments:/Conditions: ① STUB-OUT PLUMBING AS SHALLOW AS POSSIBLE IN ORDER TO SET TANK AT GROUND LEVEL ② INSTALL FIFTY CHAMBERS IN LINES ON CONTOUR AS SHOWN ③ FEED UPPER (DEEPER) LINE FIRST

Comments:/Conditions:

INITIAL SITE SKETCH SCALE: 1" = 50'

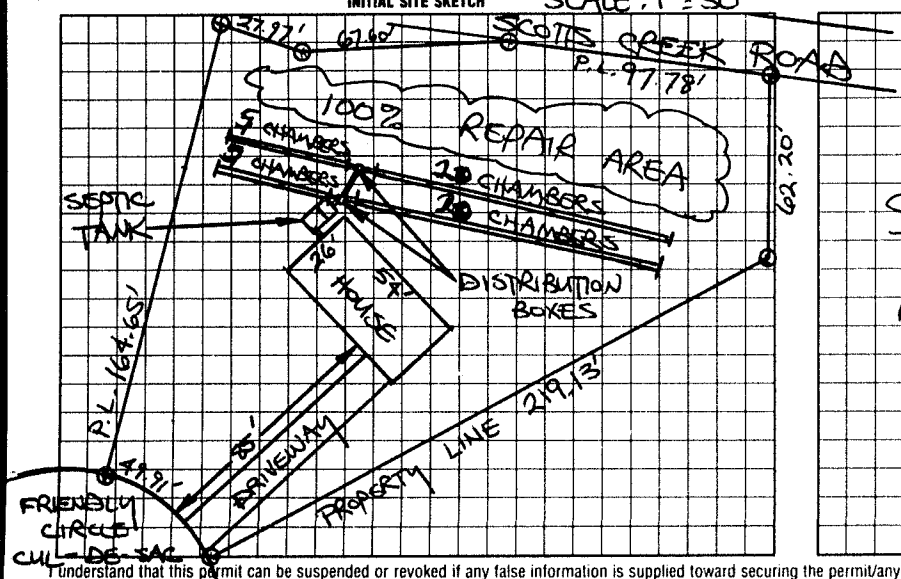


AS BUILT SKETCH

SYSTEM INSTALLED ACCORDING TO INITAL SITE SKETCH

I understand that this permit can be suspended or revoked if any false information is supplied toward securing the permit/any unauthorized changes are made to the site/any unauthorized changes are made in the installation of the system. Improvement Permit with plat valid without expiration. Improvement Permit with site plan valid for sixty months. Authorization to Construct is valid for a period equal to that of Improvement Permit – not to exceed sixty months.

Signed: [signature] date 2-24-98 Installed by: WAYNE CLONTZ

Improvement Permit by: STEVE HEDRICK date 2-12-98 Operation Permit by: STEVE HEDRICK date 1-19-99

Authorization to Construct by: STEVE HEDRICK date 2-12-98 Existing System Inspection by: ____ date ____

HEALTH DEPT. COPY: WHITE INSPECTION COPY (FINAL): GREEN OWNER COPY (FINAL): YELLOW INSPECTION COPY (INITIAL): PINK OWNER COPY (INITIAL): GOLD