IREDELL COUNTY HEALTH DEPARTMENT

STATESVILLE 704-878-5305 MOORESVILLE 704-664-5281

IMPROVEMENT PERMIT / AUTHORIZATION TO CONSTRUCT / OPERATION PERMIT / EXISTING SYSTEM INSPECTION

PERMIT# 083916 PIN# 4726 92 8189 DATE 10-4-99

OWNER OR CONTRACTOR KENNETH A WATT PHONE: Business Home 876-0047

ADDRESS 129 BECKHAM ROAD STATESVILLE NC 28625

LOCATION NC 115 NORTH, TL SCOTTS CREEK ROAD, TL ETHEL LANE, 1ST LOT ON LEFT

SUBDIVISION WOODRIDGE PARK BLOCK / SECTION LOT 1 LOT AREA 22,179.39SF SITE CLASS PS DESIGN FLOW 360 L.T.A.R. 0.30 GPD/FT²

Septic Tank: 1000 Gallons: STB 1012 Date 8-30-99
Pump Tank: Gallons: PT Date
Pump Make: Model Serial No.
Nitrification Field: No Fields 1 Square Feet EQUIV. 1200 Linear Feet 300+
No Lines FIVE Trench Width 36" Max Trench Bottom Depth 36"

☑ New System ☐ Repair System Type: I II (III) IV V VI
System Description: 25% REDUCTION SYSTEM
Repair System Description: 50% REDUCTION PUMP
Maintenance Agreement Required: ☐ Yes ☑ No
Gravel Depth SAND 6"


☑ House/Mod. Home No. Bedrooms 3
☐ Mobile Home No. Bathrooms 2
☐ Business No. Employees
☐ Other
☐ Slab ☑ Crawl Space ☐ Basement w/plumbing ☐ Basement wo/plumbing

Water Supply: ☐ Individual ☑ Public ☐ Community

Comments/Conditions: INSTALL 25% REDUCTION SYSTEM USING FIFTY (50) CHAMBERS OR THEIR (30) HDS SECTIONS AS FLAGGED

Comments/Conditions: SEPTIC TANK WITH RISERS INSTALLED USING "POLYLOK" FILTER

INITIAL SITE SKETCH SCALE: 1" 40'

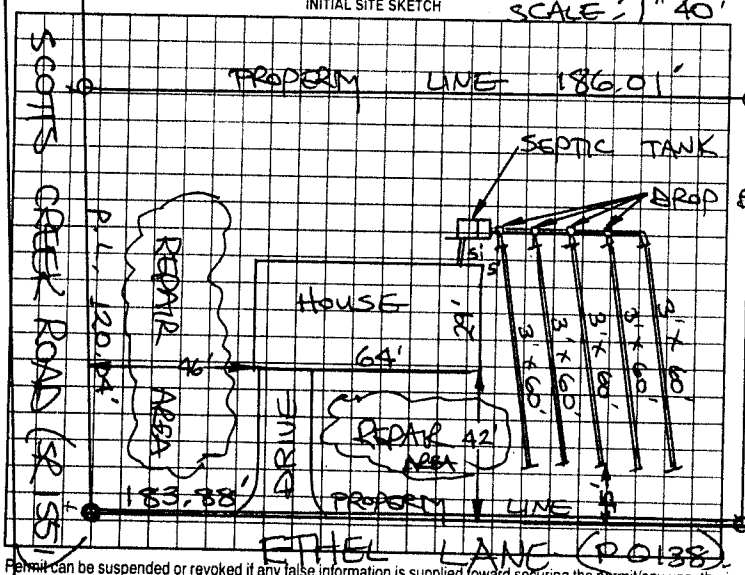

AS BUILT SKETCH

SYSTEM INSTALLED ACCORDING TO INITIAL SITE SKETCH

Permit can be suspended or revoked if any false information is supplied toward securing the permit/any unauthorized changes are made to the site/any unauthorized changes are made in the installation of the system. Improvement Permit with plat valid without expiration. Improvement Permit with site plan valid for sixty months. Authorization to Construct is valid for a period equal to that of Improvement Permit – not to exceed sixty months.

Signed: Kenneth Watt date 10-4-99

Improvement Permit by: STEVE HEDRICK date 10-4-99

Authorization to Construct by: STEVE HEDRICK date 10-4-99

Installed by: DAVID YOUNTZ

Operation Permit by: STEVE HEDRICK date 11-18-99

Existing System Inspection by: date

HEALTH DEPT COPY WHITE OWNER COPY (FINAL) YELLOW OWNER COPY (INITIAL) PINK