IREDELL COUNTY HEALTH DEPARTMENT

STATESVILLE 704-878-5305 (ow) (ow) MOORESVILLE 704-664-5281

IMPROVEMENT PERMIT / AUTHORIZATION TO CONSTRUCT / OPERATION PERMIT / EXISTING SYSTEM INSPECTION

PERMIT # 157537 PIN # 4726-92-9671 DATE 30 July 09

OWNER or APPLICANT Darrell Jones PHONE: Business (704) 902-0582 Home: (704) 876-2135

OWNER or APPLICANT ADDRESS 179 Gilead Lane Statesville, NC.

LOCATION / DIRECTIONS Scott's Creek Rd. TR Wilkesboro Hwy - TL Nikki Lane

SUBDIVISION Brandy's Acres BLOCK / SECTION LOT # 2 LOT AREA 0.84 Ac. DESIGN FLOW 360 gpd L.T.A.R. 0.3g/ft²d

Septic Tank 1000 Gallons: STB 1000 Date 10-08-09

Pump Tank Gallons: P T Date

Pump Make Model Serial #

Nitrification Field No Fields 1 No Lines 4 Linear Feet 300

Trench Width 36" Max. Trench Bottom Depth 36" Gravel Depth NA

☑ New System ☐ Repair ☐ Expansion System Type I II (III) IV V VI

System Description: 25% Reduction System

Repair System Description: 50% Reduction System.

Maintenance Agreement Required ☐ YES ☒ NO

☑ GRAVITY ☐ PRESSURE

☑ Residence No. Bedrooms 3

☐ Business No. Persons

☐ Other No. Employees

☐ Slab ☑ Crawl Space

☐ Basement w/plumbing ☐ Basement w/o plumbing

Water Supply: ☐ Private ☑ Public ☐ Community

Comments / Conditions: Follow contour / Honor all setback requirements. /

Comments / Conditions

INITIAL SITE SKETCH

* Please see Attached Site Sketch

AS BUILT SKETCH

Polybask Fill

Installed as shown on site plan.

Permit can be suspended or revoked if any false information is supplied toward securing the permit / any unauthorized changes are made to the site / any unauthorized changes are made in the installation of the system.

☐ *IMPROVEMENT PERMIT w / plat valid without expiration.* ☑ *IMPROVEMENT PERMIT w / site plan valid for 60 mos.* ☑ *AUTHORIZATION TO CONSTRUCT valid for period equal to IMPROVEMENT PERMIT-not to exceed 60 mo.*

Owner / Applicant Signature: Darrell Jones Date 9-25-09

Improvement Permit by: , R.S. Date 30 July 09

Authorzation to Construct by: , R.S. Date 30 July 09

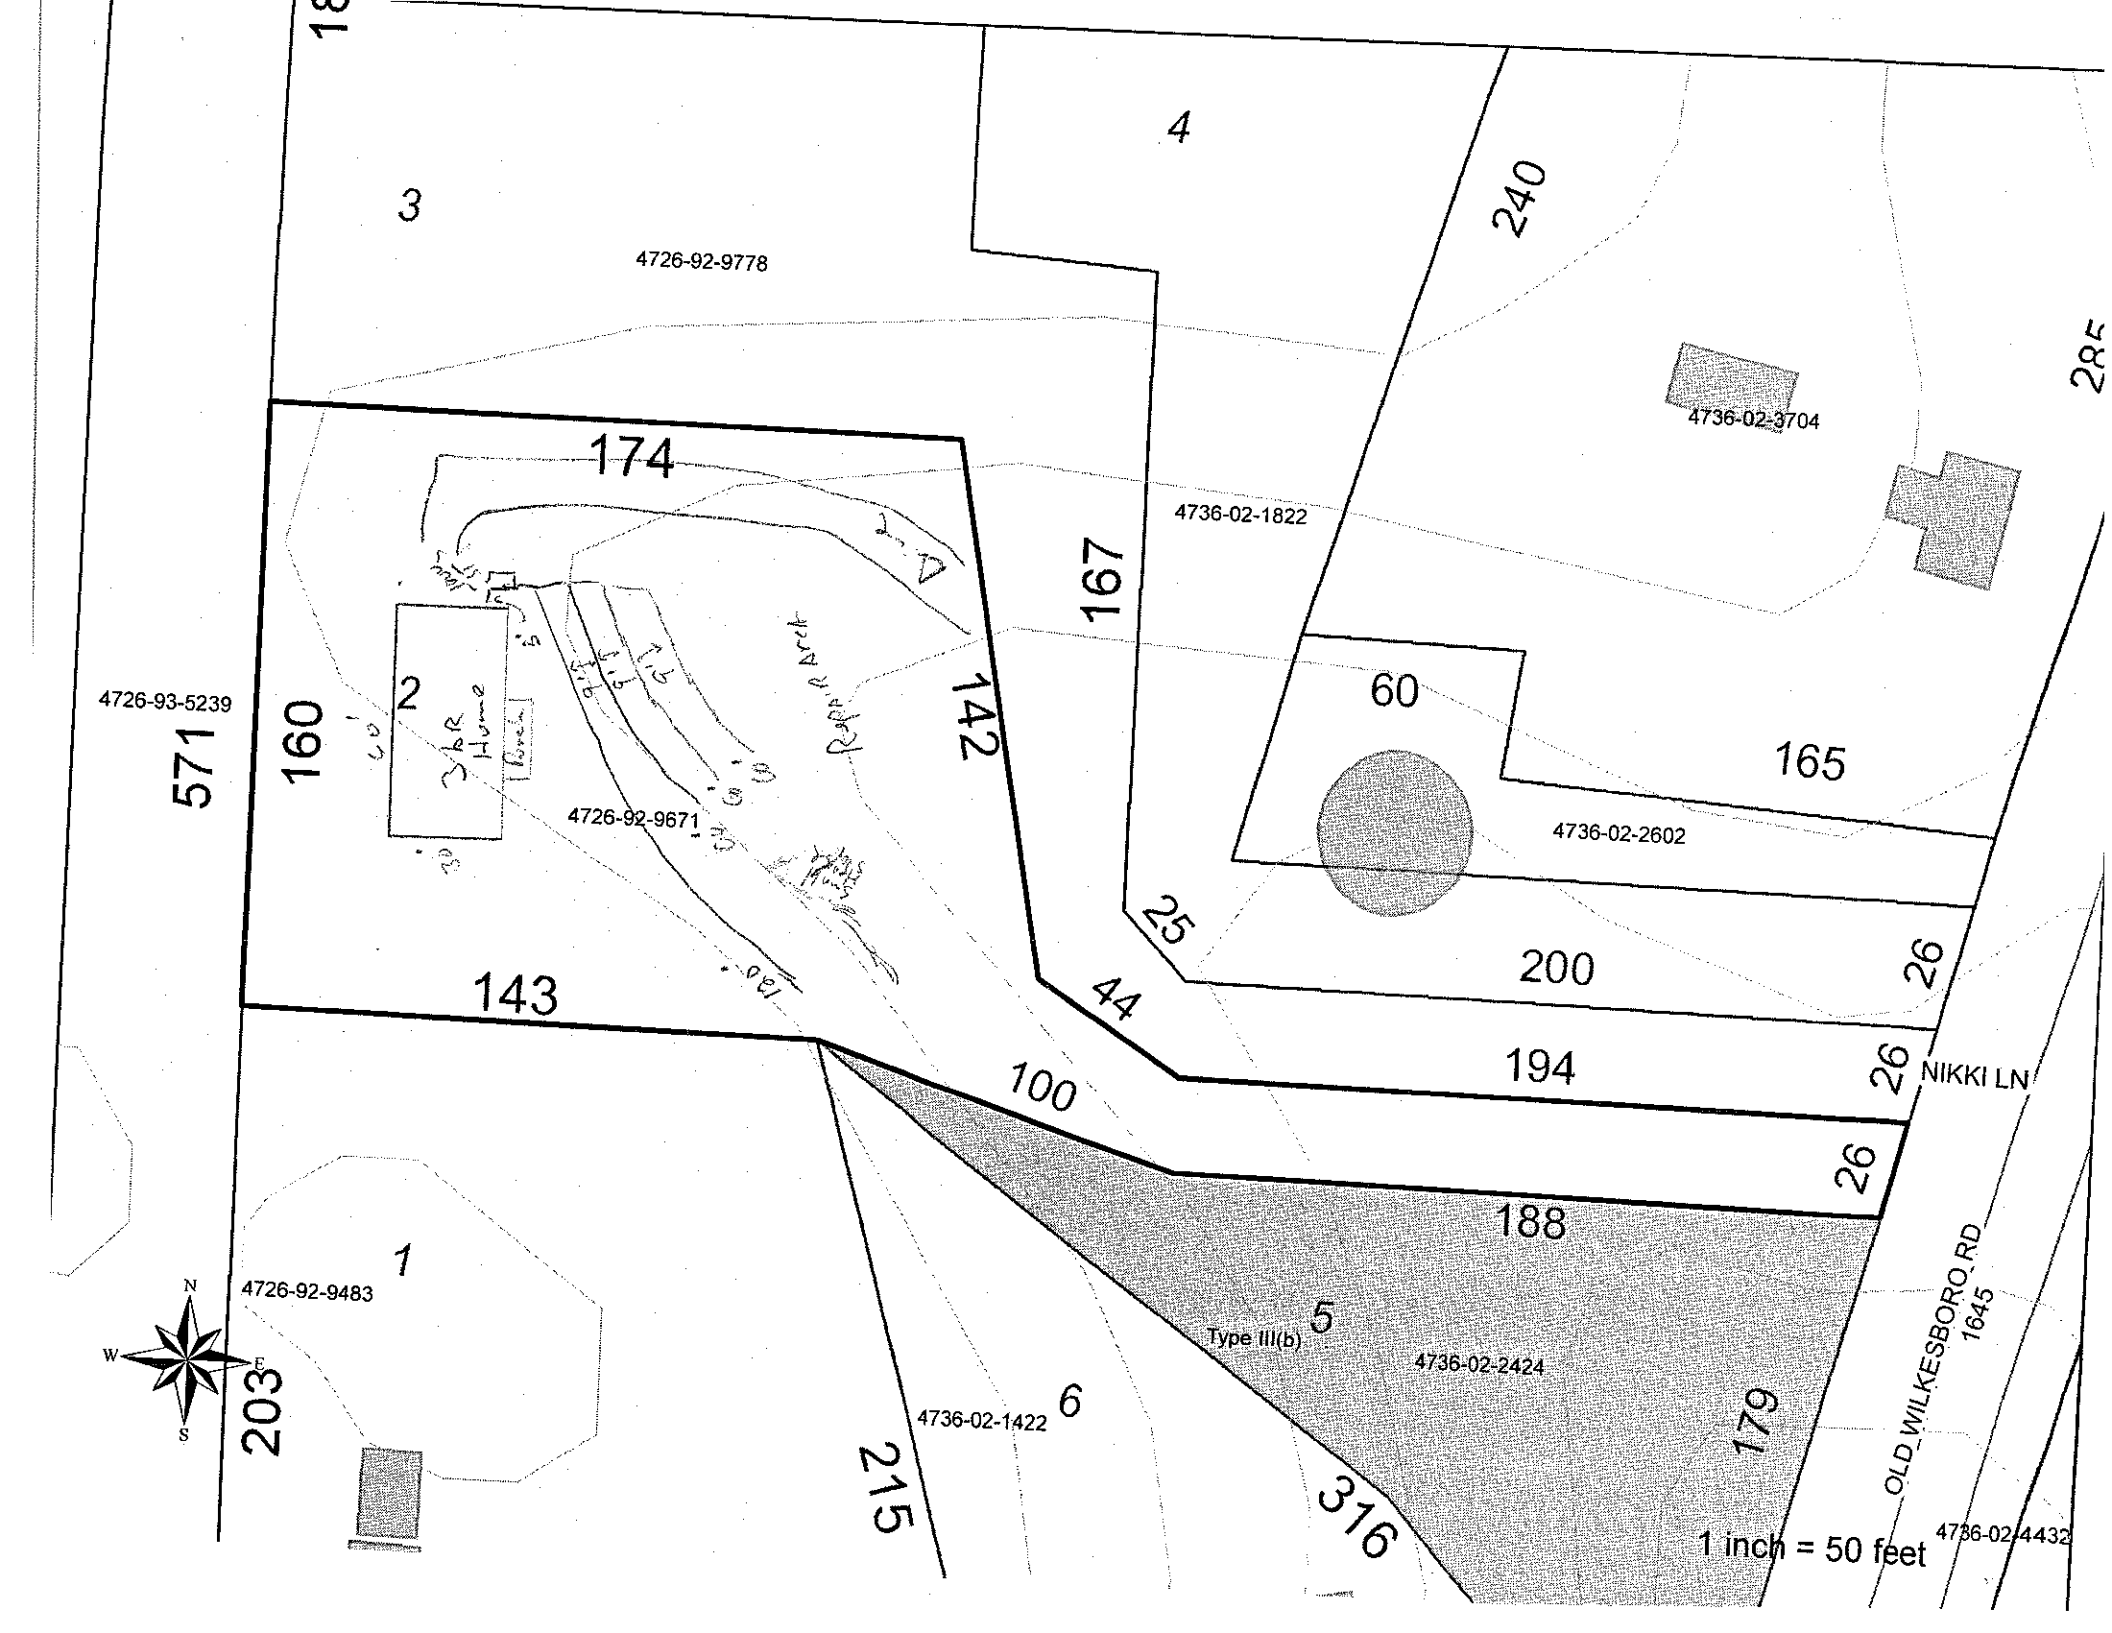
YOU SHOULD CONTACT A LOCATOR SERVICE PRIOR TO ANY EXCAVATION!

Installed by: Joey Cothren

Operation Permit by: , R.S. Date: 13 JAN. 10

Existing System Inspected by: Date:

WHITE COPY Environmental Health YELLOW COPY (Final) Owner / Applicant PINK COPY (Initial) Owner / Applicant


4
3
4726-92-9778
240
4736-02-3704
174
4736-02-1822
167
60
165
4736-02-2602
4726-93-5239
571
160
2
4726-92-9671
142
25
200
26
143
44
194
26
NIKKI LN
100
26
188
1
4726-92-9483
Type III(b)
5
4736-02-2424
203
4736-02-1422
6
215
179
316
OLD WILKESBORO RD
1645
1 inch = 50 feet
4736-02-4432
N
W
E
S