IREDELL COUNTY HEALTH DEPARTMENT

STATESVILLE 704-878-5305 MOORESVILLE 704-664-5281

IMPROVEMENT PERMIT / AUTHORIZATION TO CONSTRUCT / OPERATION PERMIT / EXISTING SYSTEM INSPECTION

PERMIT# 088334 PIN# 4726 96 2961 DATE 4-24-00

OWNER OR CONTRACTOR HEATHER SUMMERS PHONE: Business c/o 873-1481 Home

ADDRESS 906 FIFTH ST, STATESVILLE, NC 28677

LOCATION NC 115 NORTH, TR CROSBY ROAD, 3RD HOUSE ON RIGHT

SUBDIVISION BLOCK / SECTION LOT LOT AREA 2.77 ACRES SITE CLASS PS DESIGN FLOW 300 L.T.A.R. 0.30 GPD/FT²

Septic Tank: 1000 Gallons; STB 1012 Date 4-10-00
Pump Tank: Gallons; PT Date
Pump Make: Model Serial No.
Nitrification Field: No. Fields 1 Square Feet 1200 Linear Feet 400
No. Lines FOUR Trench Width 36" Max Trench Bottom Depth 36" Gravel Depth 12"

☑ New System ☐ Repair System Type: I (II) III, IV, V, VI
System Description: CONVENTIONAL GRAVITY
Repair System Description: CONV. GRAVITY
Maintenance Agreement Required: ☐ Yes ☑ No


☐ House/Mod. Home No. Bedrooms 3
☑ Mobile Home No. Bathrooms 2
☐ Business No. Employees
☐ Other
☐ Slab ☑ Crawl Space ☐ Basement w/plumbing ☐ Basement wo/plumbing

Water Supply: ☐ Individual ☑ Public ☐ Community


Comments/Conditions: KEEP SYSTEM MINIMUM 100' FROM ANY WELL

Comments/Conditions.

INITIAL SITE SKETCH

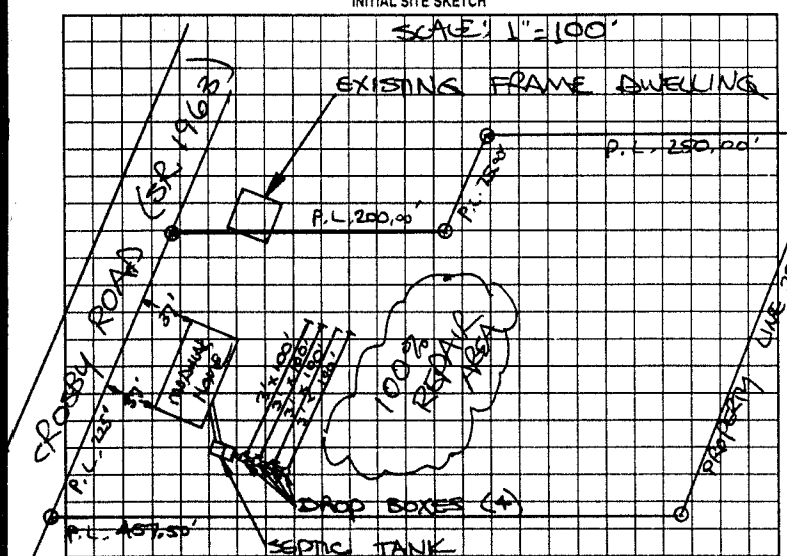

AS BUILT SKETCH

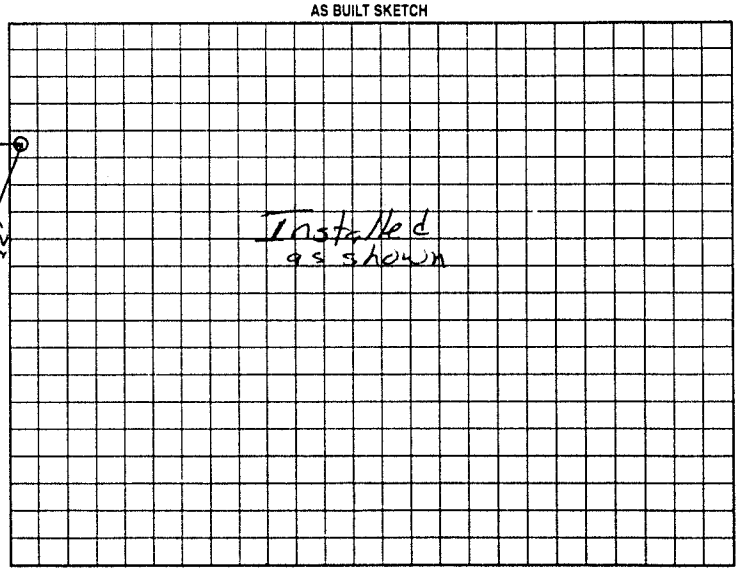

Permit can be suspended or revoked if any false information is supplied toward securing the permit/any unauthorized changes are made to the site/any unauthorized changes are made in the installation of the system. Improvement Permit with plat valid without expiration. Improvement Permit with site plan valid for sixty months. Authorization to Construct is valid for a period equal to that of Improvement Permit – not to exceed sixty months.

Signed: X [signature] date 4-24-00 Installed by: A-1 Backhoe

Improvement Permit by: STEVE HEDRICK date 4-24-00 Operation Permit by: [signature] date 5-8-00

Authorization to Construct by: STEVE HEDRICK date 4-24-00 Existing System Inspection by: date

HEALTH DEPT. COPY: WHITE OWNER COPY (FINAL): YELLOW OWNER COPY (INITIAL): PINK